

**SURVEY &
REMONUMENTATION**

APR 24 1995

OTTAWA COUNTY REMONUMENTATION
LAND CORNER RECORDATION CERTIFICATE 94 DEC 14 AM 9:41
Filing Requirement of Act 74, Mich. P.A. 1970

For corners of **COMMISSION**
Ottawa
(County)


Located In: Corner Code #

Deborah K. Sullivan
REGISTER OF DEEDS
OTTAWA COUNTY, MI

1. Public Land Survey	T <u>8N</u> R <u>14W</u>	E-3 (NW, 9) Polkton Twp.
	T _____ R _____	_____
	T _____ R _____	_____
	T _____ R _____	_____
2. Property Controlling in Section	S _____ T _____ R _____	_____
	S _____ T _____ R _____	_____
3. Miscellaneous Property in Sec.	S _____ T _____ R _____	_____
	S _____ T _____ R _____	_____

Register of Deeds Stamp & File Number

4. Lot No. _____, Recorded Plat _____
5. Private Claims _____

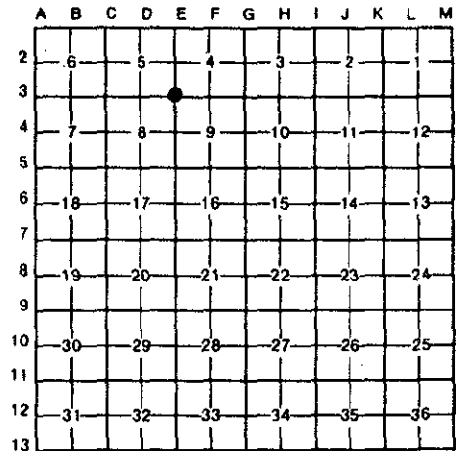

I, Donald W. Schiele, in a field survey on December 6, 19 94, do hereby certify that under requirements of P.A. 74, Michigan P.A. of 1970, the corner points mentioned in lines 1 and 2 above were in conformance with regulations and rules therefore as required in the current manual of survey instructions of the United States Department of the Interior, Bureau of Land Management or by a decree of a Court of Law and/or that the corner points mentioned in lines 3, 4 and 5 above were in conformance with the rules of the Michigan Board of Land Surveyors or by a Decree of a Court of Law; established, re-established, monumented, re-monumented, recovered, found as expressed below:

NOTE: Not more than 4 corners, all in the same town and range, may be recorded on this certificate.

A. Description of original monument and accessories and/or subsequent restoration:


E-3 corner common to Sections 4, 5, 8 & 9, Polkton Twp.
Original Government Corner Record: L.C.R.C. recorded in Liber 4, Page 287, 1-5-82
Set corner post Sec. 4,5,8,9 Set Cast Iron Monument
Post SE Power Pole 102.72'
Elm 22 S25W 11 SW Tele. Pole 72.75'
Sugar 6 N35E 16 ESE St. Sign 42.05'
John Mullett, Deputy Surveyor WSW Stop Sign 48.0'
April 13, 1837

B. Description of corner evidence found and/or method applied in restoring or reestablishing corner:

E-3 Found Cast Iron Monument (broken), 4 1/2" below surface in Monument Box, and accepted as a careful and faithful perpetuation of the position of the original corner.
Centerline Street Sign S58°E 42.1'
Found nail in SW side of Power Pole S33°30'E 102.67'
Found nail in NW side of Telephone Pole S25°W 72.74'
Centerline Stop Sign S67°W 48.0'

PA. 345 OTTAWA COUNTY
PEER APPROVED 12/12/94

Robert P. McDowell

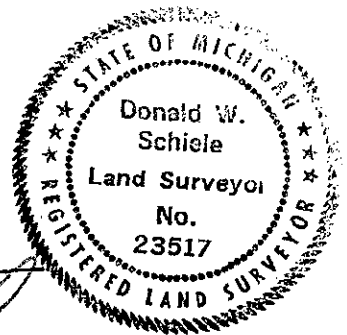

C. Description of monument for corner and accessories established to perpetuate locating the position of the corner:

E-3 Broken Cast Iron Monument, 4 1/2" below surface in Monument Box.
Set Ottawa County Remon Tag & nail in SE side of Power Pole N45°30'E 44.86'
Set Ottawa County Remon Tag & nail in SW side of Power Pole S33°30'E 102.68'
Set Ottawa County Remon Tag & nail in SE side of Power Pole S19°30'W 90.09'
Set Ottawa County Remon Tag & nail in North side of Power Pole S71°30'W 277.06'(E)
Centerline asphalt road North & South, 0.2' East
Centerline gravel road East & West, 1' South

Signed by Donald W. Schiele Date Dec 13, 1994
Surveyor's Michigan License No. 23517