99 NEC -2 PM 1: 14 OTTAWA COUNTY REMONUMENTATION

SECTION		CORNER REC				2 111 1	• •	
For corners in	Filing	g Requirement	of Act 74, N	/lich. P.A. 19	70 Jan	, Lifell	g- var	
Ottawa (County)	Located in:	Corner Cod	e#		ומשם	STER OF DEEL)S	
1. Public Land Survey	T <u>8N</u> R_1 TR_ TR_	Polk	(W%,16) kton Twp.					
Property Controlling in Section Miscellaneous Property in Sec.	S TR_ S TR_ S TR_ S TR_				Registe	r of Deeds S	tamp & File	Number
4. Lot No, Record	ded Plat				A B C	D E F		
I, <u>Donald W. Schiele</u> , requirements of P.A. 74, Michigal conformance with regulations and United States Department of the lithat the corner points mentioned Board of Land Surveyors or by recovered, found as expressed be	n P.A. of 1970, the corner rules therefore as required sterior, Bureau of Land Ma in lines 3, 4 and 5 above want of a Court of	r points mentioned in it in the current manu inagement or by a de vere in conformance	In lines 1 and 2 lat of survey inst ecree of a Court with the rules o	above were in ructions of the of Law and /or f the Michigan	2 6 3 4 7 5 6 18 7	-17-16	101	1 1 12 12 14 13 14 13 14 15 15 15 15 15 15 15 15 15 15 15 15 15
NOTE: Not more than 2 com on this certificate.	ers, all in the same town	ANA ILLUN	F V		8 —19 9 10 —30	20 21— 	27 - 2	24
7 97F	EM APPROVED	11/15/	99 V		12 31	_3233	343	536
A. Description of original more E-6 1/4 corner com Original Government Set qr section post Post Beech 10 S23E 18 Do 10 N29W 17 John Mullett, Deput April 12, 1837	Commer Record:	From 1) 2) 3)	undated O Three St Stones. Stone.	Ottawa Cou	stones p 24" Elm 5 to 24" 5 2" Plum	lanted N7		
B. Description of corner evid E-6 Found "PK" nai perpetuation of the Centerline 22" Mapl Found nail in West Found "PK" nail in	ence found and/or med 1, 3" below sur position of the e side of 28" Map	thod applied in res rface of asp ne original	corner. N19°30'E N26°30'E	1, and acc E 90.4' (E 66.75'(cepted as (E) (E)	* 34 D	OF WICH	C I NOW
C. Description of monument for E-6 Removed "PK" in	or corner and accessor ail, and replac	ries established to ced with 3/4	perpetuate lo	cating the pos	ition of the co with Ott	orner: awa Count	IAND Y Remon	Cap,
2" below surfa Set Ottawa County R Set Ottawa County R Set Ottawa County R SE corner, house fo Set Ottawa County R	ce of asphalt memon Tag & nailemon T	road in Monu in West si in North s in East si in NE side	ument Box. ide of 28' side of Pow ide of Pow	'Maple ower Pole ver Pole	N26°30 N89°30 S16°30 S69°30	'E 66.8 'E 40.3 'W 113.3 'W 130.0	31'(E) 32'(E) 36'(E) 34'(E)	Receirt #64945
On centerline aspha Centerline fence re Centerline fence re	mnants to East,	, 0.5' South		Ŀ North.	(<u>s</u>	EE SKETCH	ON REV	ERSE)

November 14, 1999

23517

Surveyor's Michigan License No.

Part A., continued:

From Ottawa County Surveyor records, 5-15-35, by R. Patterson:

Found Stone 24" Elm S.E 58.5 24" Elm E 44.0 2" Plum S.W 41.0"

From Ottawa County Road Commission road plans, 1971:

E 1/4 cor., Sec. 17 P.K. Spike SW 126.2 PP NW 37.0 TP NE 65.8 Fc. 18" Maple


FEB 2 4 2000

SECTION

From field notes by Carl Englert, Jr., 1980:

W 1/4 Cor. Sec. 16-8-14 Fd P.K. No. 1 NE 66.52 24" Maple NW 37.25 T.P. SW 125.45 P.P. NNE 90.48 16" Maple

From Ottawa County Surveyor records (at Road Commission), July, 1913 by E.H. Peck: Found Stone.

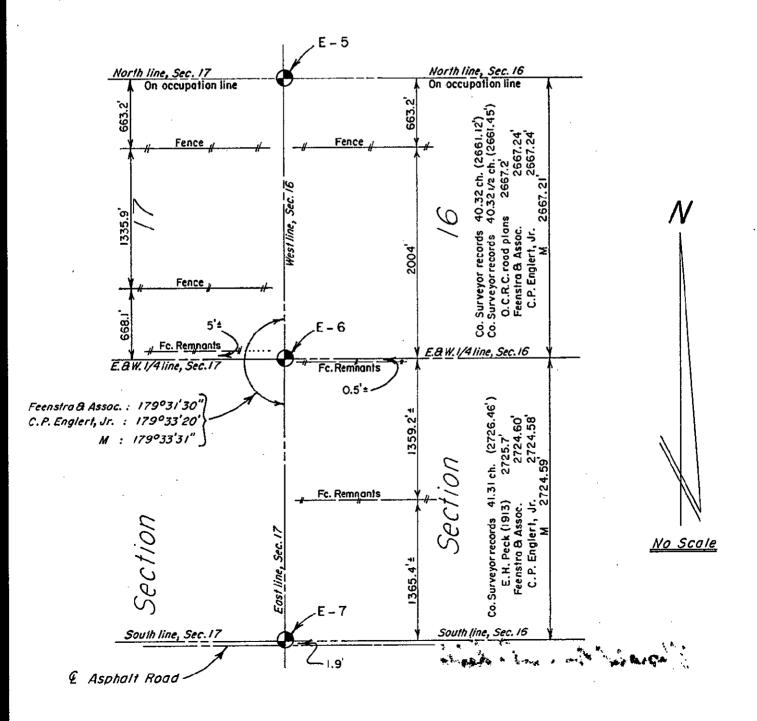

Liber 4 Page 552