RECEIVED
1993
COMMISSION

RECORDED
93 DEC 15 AM 9:27
REGISTER OF DEEDS
OTTAWA COUNTY, MI

OTTAWA COUNTY REMONUMENTATION
LAND CORNER RECORDATION CERTIFICATE
Filing Requirement of Act 74, Mich. P.A. 1970

For corners in
Ottawa (County)

	Located In:	Corner Code ##
1. Public Land Survey	T 8N R 14W	E-10 (W¼, 28)
	T ___ R ___	Polkton Twp.
	T ___ R ___	
	T ___ R ___	
2. Property Controlling	S ___ T ___ R ___	
in Section	S ___ T ___ R ___	
3. Miscellaneous	S ___ T ___ R ___	
Property in Sec.	S ___ T ___ R ___	

Register of Deeds Stamp & File Number

4. Lot No. _____, Recorded Plat _____
5. Private Claims _____

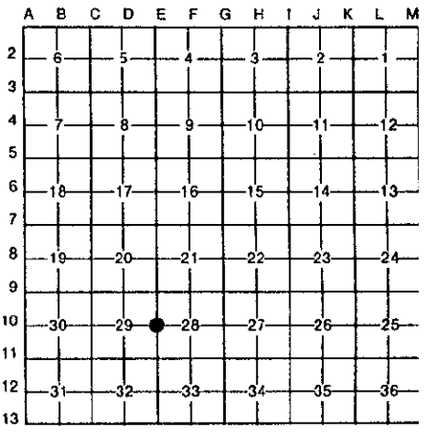

I, Donald W. Schiele, in a field survey on December 1, 19 93, do hereby certify that under requirements of P.A. 74, Michigan P.A. of 1970, the corner points mentioned in lines 1 and 2 above were in conformance with regulations and rules therefore as required in the current manual of survey instructions of the United States Department of the Interior, Bureau of Land Management or by a decree of a Court of Law and/or that the corner points mentioned in lines 3, 4 and 5 above were in conformance with the rules of the Michigan Board of Land Surveyors or by a Decree of a Court of Law; established, re-established, monumented, re-monumented, recovered, found as expressed below:

NOTE: Not more than 4 corners, all in the same town and range, may be recorded on this certificate.

A. Description of original monument and accessories and/or subsequent restoration:
E-10 corner common to Sections 28 & 29, Polkton Twp.
L.C.R.C. recorded in Liber 3, Page 177, 9-16-77 -- L.C.R.C. recorded in Liber 5, Page 283, 11-30-87.
1/2" Rod
No Witnesses
Center of Sec 28 E 2677.20'
1/2" capped re-rod # 18987
PK nail in NW side wood fc post SW 1.10'
PK nail in E side wood fc post N 28.84'
On field division to W and on N-S brush and fc row
Centerline steel T fc post S 0.50'
Top angle iron fc post S 10.84'

B. Description of corner evidence found and/or method applied in restoring or reestablishing corner:
E-10 Found 1/2" capped re-rod # 18987 leaning ESE, straightened, and accepted as a careful and faithful perpetuation of the position of the original corner.
Centerline steel T fence post South 0.50'
On field division line to West and on brush & fence row to North.

C. Description of monument for corner and accessories established to perpetuate locating the position of the corner:
E-10 Set 3/4" X 36" solid bar with Ottawa County Remon Cap at surface level in place of 1/2" capped re-rod # 18987.

Set Ottawa County Remon Tag & nail in SE side of 12" Elm	N33°E	797.40'(E)
Set Ottawa County Remon Tag & nail in SE side of 8" Twin Elm	N43°E	914.10'(E)
Centerline steel fence post	S12°E	0.50'
Set Ottawa County Remon Tag & nail in West side of 4" Cherry	N02°W	42.17'
Set Ottawa County Remon Tag & nail in East side of 3" Cherry	N01°W	39.81'

On field division line to West
On brush and fence row to North

Signed by Donald W. Schiele Date DEC. 6, 1993
Surveyor's Michigan License No. 23517

STATE OF MICHIGAN
Donald W. Schiele
Land Surveyor
No. 23517
REGISTERED LAND SURVEYOR

FORM APPROVED BY MICHIGAN STATE BOARD OF LAND SURVEYORS, JAN. 28, 197
REVISED MAY 14, 197
REVISED JAN. 1998