

**SURVEY & REMONUMENTATION**

**FEB 27 1998**

**OTTAWA COUNTY REMONUMENTATION**

**SECTION**

**LAND CORNER RECORDATION CERTIFICATE**  
Filing Requirement of Act 74, Mich. P.A. 1970

For corners in

OTTAWA

(County)

Located In:

Corner Code #

- |                                    |   |                  |
|------------------------------------|---|------------------|
| 1. Public Land Survey              | T <u>8N</u> R <u>14W</u>                  | E-13, SE corner  |
|                                    | T <u>    </u> R <u>    </u>               | Sec.32 Polkton   |
|                                    | T <u>    </u> R <u>    </u>               | Twp. <u>    </u> |
|                                    | T <u>    </u> R <u>    </u>               |                  |
| 2. Property Controlling in Section | S <u>    </u> T <u>    </u> R <u>    </u> |                  |
|                                    | S <u>    </u> T <u>    </u> R <u>    </u> |                  |
| 3. Miscellaneous                   | S <u>    </u> T <u>    </u> R <u>    </u> |                  |
| Property in Sec.                   | S <u>    </u> T <u>    </u> R <u>    </u> |                  |

**RECORDED**

**97 DEC -8 AM 11:38**

*Dan S. Vugteveen*  
REGISTRAR OF DEEDS  
OTTAWA COUNTY, MI

Register of Deeds Stamp & File Number

4. Lot No. \_\_\_\_\_, Recorded Plat \_\_\_\_\_  
5. Private Claims \_\_\_\_\_

I, Randal J. Vugteveen, in a field survey on November 21, 1997 do hereby state that under requirements of P.A. 74, Michigan P.A. of 1970, the corner points mentioned in lines 1 and 2 above were in conformance with regulations and rules therefore as required in the current manual of survey instructions of the United States Department of the Interior, Bureau of Land Management or by a decree of a Court of Law and for that the corner points mentioned in lines 3, 4 and 5 above were in conformance with the rules of the Michigan Board of Land Surveyors or by a Decree of a Court of Law; established, re-established, monumented, recovered, found as expressed below:

NOTE: Not more than 2 corners, all in the same town and range, may be recorded on this certificate.

|    | A  | B | C  | D | E  | F | G  | H | I  | J | K  | L | M |
|----|----|---|----|---|----|---|----|---|----|---|----|---|---|
| 1  |    |   |    |   |    |   |    |   |    |   |    |   |   |
| 2  | 6  |   | 5  |   | 4  |   | 3  |   | 2  |   | 1  |   |   |
| 3  |    |   |    |   |    |   |    |   |    |   |    |   |   |
| 4  | 7  |   | 8  |   | 9  |   | 10 |   | 11 |   | 12 |   |   |
| 5  |    |   |    |   |    |   |    |   |    |   |    |   |   |
| 6  | 18 |   | 17 |   | 16 |   | 15 |   | 14 |   | 13 |   |   |
| 7  |    |   |    |   |    |   |    |   |    |   |    |   |   |
| 8  | 19 |   | 20 |   | 21 |   | 22 |   | 23 |   | 24 |   |   |
| 9  |    |   |    |   |    |   |    |   |    |   |    |   |   |
| 10 | 30 |   | 29 |   | 28 |   | 27 |   | 26 |   | 25 |   |   |
| 11 |    |   |    |   |    |   |    |   |    |   |    |   |   |
| 12 | 31 |   | 32 |   | 33 |   | 34 |   | 35 |   | 36 |   |   |
| 13 |    |   |    |   |    |   |    |   |    |   |    |   |   |

A. Description of original monument and accessories and/or subsequent restoration:

- |                            |                           |   |
|----------------------------|---------------------------|---|
| E-13                       |                           |   |
| G.L.O. survey              | L.C.R.C. Liber 1 Page 577 | L.C.R.C. Liber 3 Page 183                   |
| 1837 surveyor John Mullett | Iron pipe 7-25-72         | 1" pipe 9-3-77                              |
| 6" beech N23°E 25 links    | 18" twin oak SE 61.30'    | North 15" stump 35.05'                      |
| 14" hemlock N82°W 19 links | 18" maple SE 64.09'       | NE 8" ironwood 49.68'                       |
|                            | 14" stump North 35.0'     | SE 15" hemlock 78.30'                       |
|                            |                           | NOTE: (See back for additional information) |


B. Description of corner evidence found and/or method applied in restoring or reestablishing corner:

- |   |  |
|---|--|
| E-13 Found Cast Iron Monument               |  |
| Nail & Washer NE side 21" Hemlock SE 78.52' | Accepted position of cast iron monument as a careful perpetuation of the position of the original corner |
| Nail S. Side 15" Oak NNE 40.83'             |  |
| Nail & Washer SW Side 22" Oak SE 60.68'     |  |

**P.A. 345 OTTAWA COUNTY**  
**PEER APPROVED** 12/1/97  
*YDR*

C. Description of monument for corner and accessories established to perpetuate locating the position of the corner:

- E-13
- Cast Iron Monument
- Set Ottawa County Remon tag & nail SW side 22" Oak AZ 132° 60.68'
  - Set Ottawa County Remon tag & nail NE side 21" Hemlock 119° 78.59'
  - Set Ottawa County Remon tag & nail SE side AZ 23° 41.54'
  - Set Ottawa County Remon tag & nail W side 12" Oak AZ 353° 48.94'
  - Centerline Hayes South 3'
  - F-13 South 1/4 corner Section 33, T8N, R14W East 2668.83'

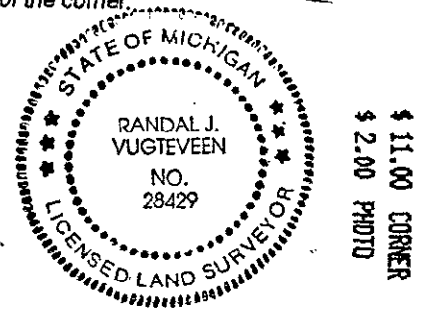

Signed by *Randal J. Vugteveen*  
Surveyor's Michigan License No. 28429

Date Dec. 1, 1997

L.C.R.C. Liber 4, Page 126  
Cast Iron Monument 11-14-80  
7" Poplar NW 50.52'  
19" Pine SE 77.56'  
13" Tree NNE 41.27'

**SURVEY &  
REMONUMENTATION**

**FEB 27 1998**

**SECTION**