

# SURVEY & REMONUMENTATION

FEB 27 1998

SECTION

## OTTAWA COUNTY REMONUMENTATION LAND CORNER RECORDATION CERTIFICATE Filing Requirement of Act 74, Mich. P.A. 1970

For corners in

OTTAWA

(County)

Located In:

Corner Code #

1. Public Land Survey

T8N R 14W  
T R  
T R  
T R

F-13, S1/4, cor.,  
Sec.33, Polkton  
Twp.

2. Property Controlling in Section

S T R  
S T R

3. Miscellaneous Property in Sec.

S T R  
S T R

RECORDED

97 DEC -8 AM 11:27

*Randy Mullett*  
REGISTER OF DEEDS  
OTTAWA COUNTY, MI

Register of Deeds Stamp & File Number

4. Lot No. \_\_\_\_\_, Recorded Plat \_\_\_\_\_

5. Private Claims \_\_\_\_\_

I, Randal J. Vugteveen, in a field survey on November 21, 19 97 do hereby state that under requirements of P.A. 74, Michigan P.A. of 1970, the corner points mentioned in lines 1 and 2 above were in conformance with regulations and rules therefore as required in the current manual of survey instructions of the United States Department of the Interior, Bureau of Land Management or by a decree of a Court of Law and/or that the corner points mentioned in lines 3, 4 and 5 above were in conformance with the rules of the Michigan Board of Land Surveyors or by a Decree of a Court of Law; established, re-established, monumented, recovered, found as expressed below.

NOTE: Not more than 2 corners, all in the same town and range, may be recorded on this certificate.

	A	B	C	D	E	F	G	H	I	J	K	L	M	
1														
2	6			5			4			3			2	1
3														
4	7			8			9			10			11	12
5														
6	13			17			16			15			14	13
7														
8	19			20			21			22			23	24
9														
10	30			29			28			27			26	25
11														
12	31			32			33			34			35	36
13														

A. Description of original monument and accessories and/or subsequent restoration:

F-13  
G.L.O. survey notes 1837 survey - John Mullett  
Set post  
6" Hemlock N22°E 10 links  
13" Hemlock N63°W 25 links

L.C.R.C Liber 3 Page 84 5-12-76  
1/2" iron  
36" Maple N70°E 70.60'  
Telephone pole S50°E 40.43'  
42" Ash S60°W 59.43'

L.C.R.C. Liber 4 Page 127 11-11-80  
Cast iron monument  
36" Maple NE 70.62'  
48" Oak SW 59.41'  
Telephone pole SE 40.45'  
18" Walnut NW 86.05'

B. Description of corner evidence found and/or method applied in restoring or reestablishing corner:

F-13 Found cast iron Ottawa County Monument

38" Maple NE 70.5'  
60" Oak SW 58.6'  
22" Walnut NW 86'


Accepted position of cast iron monument as a careful perpetuation of the position of the original corner

P.A. 345 OTTAWA COUNTY  
PEER APPROVED 12/1/97

C. Description of monument for corner and accessories established to perpetuate locating the position of the corner:

F-13 Cast iron Ottawa County Monument

Set Ottawa County Remon tag & nail SE side 38" Maple AZ 70.50'  
Set Ottawa County Remon tag & nail NE side 30" Oak AZ 112° 51.36'  
Set Ottawa County Remon tag & nail NW side 60" Oak AZ 247° 58.61'  
Set Ottawa County Remon tag & nail E side 22" Walnut AZ 344° 85.72'  
Centerline East-West road South 2'  
On centerline of road to North

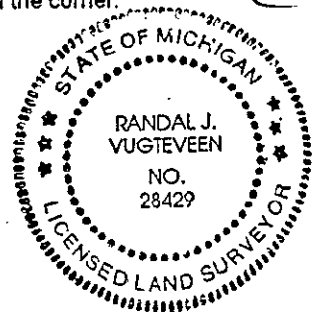

\* 7x11 UNCLIP  
\$ 1.00 PHOTO

Signed by *Randal J. Vugteveen*  
Surveyor's Michigan License No. 28429

Date Dec. 1, 1997