

**SURVEY & REMONUMENTATION**

MAR 08 1994

OTTAWA COUNTY REMONUMENTATION  
**LAND CORNER RECORDATION CERTIFICATE**  
 Filing Requirement of Act 74, Mich. P.A. 1970

RECORDED


93 NOV -8 PM 1:58

*Debra A. Robinson*  
 REGISTER OF DEEDS  
 OTTAWA COUNTY, MI

For corners in COMMISSION  
Ottawa  
 (County)

	Located In:	Corner Code #
1. Public Land Survey	T <u>8N</u> R <u>14W</u>	<u>G-3 (NW, 10)</u> <u>Polkton Twp.</u>
	T _____ R _____	_____
	T _____ R _____	_____
	T _____ R _____	_____
2. Property Controlling in Section	S _____ T _____ R _____	_____
	S _____ T _____ R _____	_____
3. Miscellaneous Property in Sec.	S _____ T _____ R _____	_____
	S _____ T _____ R _____	_____
4. Lot No. _____, Recorded Plat _____		
5. Private Claims _____		

Register of Deeds Stamp & File Number

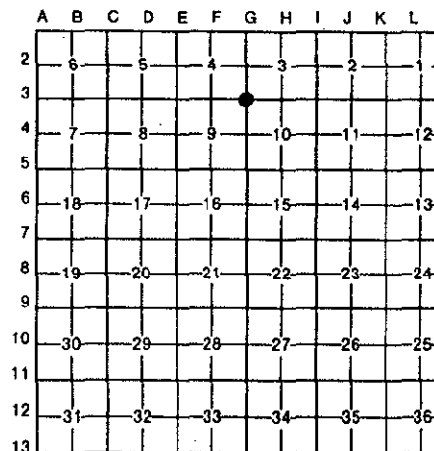

I, Donald W. Schiele, in a field survey on October 15th, 19 93, do hereby certify that under requirements of P.A. 74, Michigan P.A. of 1970, the corner points mentioned in lines 1 and 2 above were in conformance with regulations and rules therefore as required in the current manual of survey instructions of the United States Department of the Interior, Bureau of Land Management or by a decree of a Court of Law and/or that the corner points mentioned in lines 3, 4 and 5 above were in conformance with the rules of the Michigan Board of Land Surveyors or by a Decree of a Court of Law; established, re-established, monumented, re-monumented, recovered, found as expressed below:

**NOTE: Not more than 4 corners, all in the same town and range, may be recorded on this certificate.**

A. Description of original monument and accessories and/or subsequent restoration:

G-3 corner common to Sections 3, 4, 9 and 10 Polkton Twp.  
 L.C.R.C. recorded in Liber 4, Page 111, 10-14-80  
 C.I.M. Inscribed "Section Corner"  
 Street Sign NNE. 24.76  
 Power Pole NW. 113.33  
 Power Pole NE. 135.06

B. Description of corner evidence found and/or method applied in restoring or reestablishing corner:

G-3  
 Found C.I.M. with top section gone and accepted as a careful and faithful perpetuation of the position of the original corner.  
 CL Street Sign NNE 24.85'  
 Found nail in SW side of Power Pole NW 111.32' (E)  
 Found nail and tag #18435 in NW side of Power Pole NE 134.95' (E)

C. Description of monument for corner and accessories established to perpetuate locating the position of the corner:

G-3  
 C.I.M. with top section gone 3" below surface  
 CL Street Sign N23°E 24.85'  
 Set Ottawa County Remon Tag & nail in NW side of Power Pole N68°E 135.16' (E)  
 Chiselled "X" in East end of 12" Concrete Culvert S20°E 46.82'  
 Set Ottawa County Remon Tag & nail in SE side of Power Pole S22°W 263.03' (E)  
 Set Ottawa County Remon Tag & nail in SW side of Power Pole N61°W 111.18' (E)  
 On CL gravel roads East, South and West.

Signed by Donald W. Schiele Date 10-18-93  
 Surveyor's Michigan License No. 23517

