

# SURVEY & REMONUMENTATION

NOV 10 1993

## COMMISSION

### OTTAWA COUNTY REMONUMENTATION LAND CORNER RECORDATION CERTIFICATE Filing Requirement of Act 74, Mich. P.A. 1970

For corners in

Ottawa	Located in:	.Corner Code #
(County)		
1. Public Land Survey	T <u>8N</u> R <u>14W</u>	G-5 (SW, 10)
	T _____ R _____	Polkton Twp.
	T _____ R _____	_____
	T _____ R _____	_____
2. Property Controlling	S _____ T _____ R _____	_____
in Section	S _____ T _____ R _____	_____
3. Miscellaneous	S _____ T _____ R _____	_____
Property in Sec.	S _____ T _____ R _____	_____
4. Lot No. _____, Recorded Plat _____		
5. Private Claims _____		

RECORDED

1993 SEP 29 PM 3:14

*Phyllis Johnson*  
REGISTER OF DEEDS  
OTTAWA COUNTY, MI

Register of Deeds Stamp & File Number

I, Donald W. Schiele, in a field survey on Sept. 16, 1993, do hereby certify that under requirements of P.A. 74, Michigan P.A. of 1970, the corner points mentioned in lines 1 and 2 above were in conformance with regulations and rules (hereof as required in the current manual of survey instructions of the United States Department of the Interior, Bureau of Land Management or by a decree of a Court of Law and/or that the corner points mentioned in lines 3, 4 and 5 above were in conformance with the rules of the Michigan Board of Land Surveyors or by a Decree of a Court of Law; established, re-established, monumented, re-monumented, recovered, found as expressed below:

**NOTE: Not more than 4 corners, all in the same town and range, may be recorded on this certificate.**


	A	B	C	D	E	F	G	H	I	J	K	L	M
2	6	5	4	3	2	1							
3													
4	7	8	9	10	11	12							
5													
6	18	17	16	15	14	13							
7													
8	19	20	21	22	23	24							
9													
10	30	29	28	27	26	25							
11													
12	31	32	33	34	35	36							
13													

A. Description of original monument and accessories and/or subsequent restoration:  
 G-5 corner common to Sections 9, 10, 15 and 16 Polkton Twp.  
 T.C.R.C. recorded in Liber 4, Page 274  
 C.I.M.  
 Power Pole ESE. 47.27  
 10" Pine ESE. 46.58  
 Power Pole W. 52.14  
 4" Ash SW. 66.40

B. Description of corner evidence found and/or method applied in restoring or reestablishing corner:  
 G-5  
 Found C.I.M. Inscribed "Section Corner" and accepted as a careful and faithful perpetuation of the position of the original corner.  
 Found nail in SW side of Power Pole ESE 47.16'  
 Found nail in West of 33" Ash S10°W 139.72'  
 Found nail in South side of Power Pole West 52.17'

C. Description of monument for corner and accessories established to perpetuate locating the position of the corner:  
 G-5  
 C.I.M. 3" below surface  
 Set nail and Ottawa Co. re-mon. tag in NE side of Power pole S68°E 47.27'  
 NW corner footing to house #17994 S64°E 130.54'  
 Set nail and Ottawa Co. re-mon. tag in West side of 33" Ash S10°W 139.73'  
 Set nail and Ottawa Co. re-mon. tag in South side of Power Pole S89°W 52.16'  
 Set nail and Ottawa Co. re-mon. tag in South side of Twin 7" Elm N84°W 30.24'  
 In CL North and South gravel road, on CL trail East, on CL occupation West

Signed by Donald W. Schiele Date SEPT. 20, 1993  
 Surveyor's Michigan License No. 23517

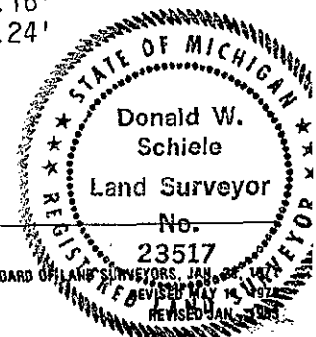

FORM APPROVED BY MICHIGAN STATE BOARD OF LAND SURVEYORS, JAN 1988, REVISED MAY 1992, REVISED JAN 1993