

1893
COMMISSION

OTTAWA COUNTY REMONUMENTATION
LAND CORNER RECORDATION CERTIFICATE
Filing Requirement of Act 74, Mich. P.A. 1970

RECORDED

93 DEC 15 AM 9:27

Daphne C. Johnson
REGISTER OF DEEDS
OTTAWA COUNTY, MI

For corners in

Ottawa (County)	Located In:	Corner Code #
1. Public Land Survey	T <u>8N</u> R <u>14W</u>	<u>G-10 (E$\frac{1}{4}$, 28)</u> <u>Polkton Twp.</u>
	T _____ R _____	_____
	T _____ R _____	_____
	T _____ R _____	_____
2. Property Controlling in Section	S _____ T _____ R _____	_____
	S _____ T _____ R _____	_____
3. Miscellaneous Property in Sec.	S _____ T _____ R _____	_____
	S _____ T _____ R _____	_____

Register of Deeds Stamp & File Number

4. Lot No. _____, Recorded Plat _____
5. Private Claims _____

I, Donald W. Schiele, in a field survey on December 3, 19 93, do hereby certify that under requirements of P.A. 74, Michigan P.A. of 1970, the corner points mentioned in lines 1 and 2 above were in conformance with regulations and rules therefore as required in the current manual of survey instructions of the United States Department of the Interior, Bureau of Land Management or by a decree of a Court of Law and/or that the corner points mentioned in lines 3, 4 and 5 above were in conformance with the rules of the Michigan Board of Land Surveyors or by a Decree of a Court of Law; established, re-established, monumented, re-monumented, recovered, found as expressed below:

NOTE: Not more than 4 corners, all in the same town and range, may be recorded on this certificate.

	A	B	C	D	E	F	G	H	I	J	K	L	M
2	6	5	4	3	2	1							
3													
4	7	8	9	10	11	12							
5													
6	18	17	16	15	14	13							
7													
8	19	20	21	22	23	24							
9													
10	30	29	28	27	26	25							
11													
12	31	32	33	34	35	36							
13													

A. Description of original monument and accessories and/or subsequent restoration:


G-10 corner common to Sections 27 & 28, Polkton Twp.	L.C.R.C. recorded in Liber 3, Page 177, 9-16-77	L.C.R.C. recorded in Liber 4, Page 304, 4-1-82	L.C.R.C. recorded in Liber 5, Page 205, 5-3-85
1/2" Steel Rod	Cast Iron Monument	1/2" re-rod	
SSE 6" Elm 8.20'	8" Elm WSW 25.34'	Nail in N side 12" Elm WSW 25.34'	
WSW 8' Elm 25.34'	6" Elm SSW 8.20'	Nail in W side 6" Elm SSE 8.20'	
ENE 6" Elm 10.49'	7" Elm East 21.29'	Nail in S side 6" Willow E 21.35'	
E 7" Elm 21.29'	6" Elm ENE 10.49'	Nail in NW side 8" Maple NE 30.86'	
		Nail in S side dead 6" Elm E 8.40'	
		On centerline E-W ditch	

B. Description of corner evidence found and/or method applied in restoring or reestablishing corner: On tree row N-S
G-10 Found 1/2" X 18" capped re-rod # 27459 on North edge of bend in ditch to South and accepted as a careful and faithful perpetuation of the position of the original corner.
Found nail in NW side of 14" Oak NE 30.90'
Found double-headed nail in North side of dead 12" tree WSW 25.34'
On tree row and old fence line to North
On centerline straight part of East & West ditch
On occupation line to South

C. Description of monument for corner and accessories established to perpetuate locating the position of the corner:
G-10 Set 3/4" X 36" solid bar with Ottawa County Remon Cap 2" above ground level in place of 1/2" X 18" capped re-rod #27459.

Set Ottawa County Remon Tag & nail in East side of 5" Cherry	N04°E	15.57'
Set Ottawa County Remon Tag & nail in NW side of 14" Oak	N59°E	30.89'
Set Ottawa County Remon Tag & nail in South side of 10" Cherry	S74°E	39.99'
Set Ottawa County Remon Tag & nail in South side of 20" Elm	S78°W	41.82'
Set Ottawa County Remon Tag & nail in North side of 12" Ash	N72°W	32.07'
On tree row and old fence line to North		
On centerline straight part of East & West ditch		
On occupation line to South		

Signed by Donald W. Schiele Date DEC. 6, 1993
Surveyor's Michigan License No. 23517

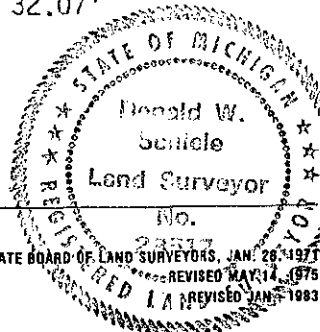

FORM APPROVED BY MICHIGAN STATE BOARD OF LAND SURVEYORS, JAN. 28, 1971
REVISED MAY 14, 1975