

OTTAWA COUNTY REMONUMENTATION
 LAND CORNER RECORDATION CERTIFICATE
 Filing Requirement of Act 74, Mich. P.A. 1970

RECORDED

93 DEC 15 AM 9:27

For corners in

Ottawa (County) Located In: Corner Code #

1. Public Land Survey T 8N R 14W G-11 (SE, 28)
 T _____ R _____ Polkton Twp.
 T _____ R _____
 T _____ R _____

2. Property Controlling S _____ T _____ R _____
 in Section S _____ T _____ R _____

3. Miscellaneous S _____ T _____ R _____
 Property in Sec. S _____ T _____ R _____

4. Lot No. _____, Recorded Plat _____

5. Private Claims _____

Richard L. Robinson
 REGISTER OF DEEDS
 OTTAWA COUNTY, MI

SURVEY &
 REMONUMENTATION

DEC 05 2000

SECTION

Register of Deeds Stamp & File Number

	A	B	C	D	E	F	G	H	I	J	K	L	M
2	6		5		4		3		2		1		
3													
4	7		8		9		10		11		12		
5													
6	18		17		16		15		14		13		
7													
8	19		20		21		22		23		24		
9													
10	30		29		28		27		26		25		
11													
12	31		32		33		34		35		36		
13													

I, Donald W. Schiele in a field survey on December 3, 19 93, do hereby certify that under requirements of P.A. 74, Michigan P.A. of 1970, the corner points mentioned in lines 1 and 2 above were in conformance with regulations and rules therefore as required in the current manual of survey instructions of the United States Department of the Interior, Bureau of Land Management or by a decree of a Court of Law and/or that the corner points mentioned in lines 3, 4 and 5 above were in conformance with the rules of the Michigan Board of Land Surveyors or by a Decree of a Court of Law; established, re-established, monumented, re-monumented, recovered, found as expressed below:

NOTE: Not more than 4 corners, all in the same town and range, may be recorded on this certificate.

A. Description of original monument and accessories and/or subsequent restoration:
 G-11 corner common to Sections 27, 28, 33 & 34, Polkton Twp.

L.C.R.C. recorded in Liber 2, Page 785, 6-25-75. L.C.R.C. recorded in Liber 4, Page 127, 11-26-80
 3/4" Iron C.I.M.
 PK in sde P. Pole South 49.69' Power Pole South 49.69'
 PK in sde fence post North 26.65' Fence Post North 34.14'
 PK in sde guy pole WNW 191.36' West End Conc. Culv. SW 36.27'
 Fence to North West 1.5'


B. Description of corner evidence found and/or method applied in restoring or reestablishing corner:

G-11 Found Cast Iron Monument in Monument Box with top broken off 12" below surface and accepted as a careful and faithful perpetuation of the position of the original corner.
 Found PK nail in NE side of Telephone Pole WNW 193.08'(E)
 Centerline old fence line to North, 0.5'± West
 South 1/4 Corner, Sec. 28 West 2654.45'(E)

C. Description of monument for corner and accessories established to perpetuate locating the position of the corner:

G-11 Set 3/4" X 9" solid bar with Ottawa County Remon Cap in Monument Box 2" below surface over Cast Iron Monument.
 Set Ottawa County Remon Tag & nail in NE side of Power Pole S30°E 56.22'
 NE corner brick veneer to House # 7200 S31°W 143.74'(E)
 Set Ottawa County Remon Tag & nail in North side of Power Pole S75°W 174.92'(E)
 Set Ottawa County Remon Tag & nail in North side of Telephone Pole N78°W 193.28'(E)
 Centerline old fence row to North, 0.5'± West
 On occupation line to South
 On centerline asphalt road East & West

Signed by Donald W. Schiele Date Dec. 5, 1993
 Surveyor's Michigan License No. 23517

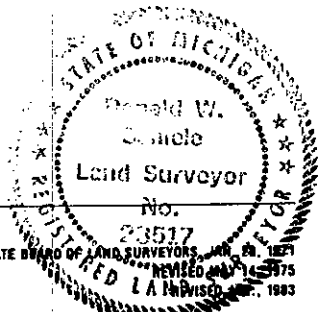

FORM APPROVED BY MICHIGAN STATE BOARD OF LAND SURVEYORS, REVISED MAY 1975