

SURVEY & REMONUMENTATION

FEB 27 1998

OTTAWA COUNTY REMONUMENTATION LAND CORNER RECORDATION CERTIFICATE Filing Requirement of Act 74, Mich. P.A. 1970

SECTION

For corners in

OTTAWA

(County)

Located In:

Corner Code #

- | | | |
|---------------------------------------|----------------------------|---|
| 1. Public Land Survey | T <u>8</u> N R <u>14</u> W | G-12, E 1/4 corner,
Sec. 33, Polkton
Twp. _____ |
| | T _____ R _____ | _____ |
| | T _____ R _____ | _____ |
| | T _____ R _____ | _____ |
| 2. Property Controlling
in Section | S _____ T _____ R _____ | _____ |
| | S _____ T _____ R _____ | _____ |
| 3. Miscellaneous
Property in Sec. | S _____ T _____ R _____ | _____ |
| | S _____ T _____ R _____ | _____ |

RECORDED

97 DEC -8 AM 11:28

Randy D. ...
REGISTER OF DEEDS
OTTAWA COUNTY, MI

Register of Deeds Stamp & File Number

4. Lot No. _____, Recorded Plat _____
5. Private Claims _____

I, Randal J. Vugteveen, in a field survey on November 21, 1997 do hereby state that under requirements of P.A. 74, Michigan P.A. of 1970, the corner points mentioned in lines 1 and 2 above were in conformance with regulations and rules therefore as required in the current manual of survey instructions of the United States Department of the Interior, Bureau of Land Management or by a decree of a Court of Law and/or that the corner points mentioned in lines 3, 4 and 5 above were in conformance with the rules of the Michigan Board of Land Surveyors or by a Decree of a Court of Law, established, re-established, monumented, recovered, found as expressed below:

NOTE: Not more than 2 corners, all in the same town and range, may be recorded on this certificate.

1	A	B	C	D	E	F	G	H	I	J	K	L	M
2	6	5	4	3	2	1							
3													
4	7	8	9	10	11	12							
5													
6	10	17	16	15	14	13							
7													
8	19	20	21	22	23	24							
9													
10	30	29	28	27	26	25							
11													
12	31	32	33	34	35	36							
13													

A. Description of original monument and accessories and/or subsequent restoration:

- | | | |
|--|--|--|
| G-12
G.L.O. survey notes
1837 surveyor John Mullett
Set quarter section post
24" hemlock S13°E 14 links
13" hemlock NW 17 links | L.C.R.C. Liber 2 Page 785 6-12-75
Found 1/2" iron
Nail in 8" poplar WNW 24.24'
Nail in 8" poplar ESE 6.06'
Corner fence post West 0.7'
Fence to N S E & W | L.C.R.C. Liber 4 Page 51 2-29-80
Set cast iron monument
5" aspen NNE 11.20'
3" oak NE 12.31'
Wood fence post W 0.7'
8" aspen WNW 24.24'
8" aspen ESE 6.06' |
|--|--|--|

B. Description of corner evidence found and/or method applied in restoring or reestablishing corner:

G-12 Found cast iron monument

On tree rows North, South and West
Traces of fence North and South


Accepted position of cast iron monument as a careful
perpetuation of the position of the original corner

P.A. 345 OTTAWA COUNTY
PEER APPROVED 12/1/97

C. Description of monument for corner and accessories established to perpetuate locating the position of the corner:

G-12 Cast Iron Ottawa County Section corner

- Set Ottawa County Remon tag & nail SW side 6" cherry AZ 300° 8.18'
- Set Ottawa County Remon tag & nail SE side 7" poplar AZ 10° 2.85'
- Set Ottawa County Remon tag & nail East side 10" twin poplar AZ 195° 14.25'
- Set Ottawa County Remon tag & nail South side 14" poplar AZ 270° 27.28'

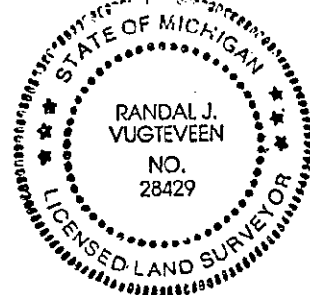

\$ 9.00 CORNER
\$ 1.00 PHOTO

Signed by *Randal J. Vugteveen*
Surveyor's Michigan License No. 28429

Date Dec 1, 1997