

# SURVEY & REMONUMENTATION

FEB 27 1998

## OTTAWA COUNTY REMONUMENTATION LAND CORNER RECORDATION CERTIFICATE Filing Requirement of Act 74, Mich. P.A. 1970

### SECTION

For corners in

OTTAWA <small>(County)</small>	Located In:	Corner Code #
1. Public Land Survey	T <u>8</u> N R <u>14</u> W	G-13, SE
	T ___ R ___	cor. Sec. 33, Polkton
	T ___ R ___	Twp ___
	T ___ R ___	_____
2. Property Controlling in Section	S ___ T ___ R ___	_____
	S ___ T ___ R ___	_____
3. Miscellaneous Property in Sec.	S ___ T ___ R ___	_____
	S ___ T ___ R ___	_____

RECORDED

97 DEC -8 AM 11:28

REGISTER OF DEEDS  
OTTAWA COUNTY, MI

Register of Deeds Stamp & File Number

4. Lot No. \_\_\_\_\_, Recorded Plat \_\_\_\_\_  
5. Private Claims \_\_\_\_\_

I, Randal J. Vugteveen, in a field survey on November 21, 19 97 do hereby state that under requirements of P.A. 74, Michigan P.A. of 1970, the corner points mentioned in lines 1 and 2 above were in conformance with regulations and rules therefore as required in the current manual of survey instructions of the United States Department of the Interior, Bureau of Land Management or by a decree of a Court of Law and /or that the corner points mentioned in lines 3, 4 and 5 above were in conformance with the rules of the Michigan Board of Land Surveyors or by a Decree of a Court of Law; established, re-established, monumented, recovered, found as expressed below:

NOTE: Not more than 2 corners, all in the same town and range, may be recorded on this certificate.

	A	B	C	D	E	F	G	H	I	J	K	L
1												
2	6		5		4		3		2		1	
3												
4	7		8		9		10		11		12	
5												
6	18		17		16		15		14		13	
7												
8	19		20		21		22		23		24	
9												
10	30		29		28		27		26		25	
11												
12	31		32		33		34		35		36	
13												

**A. Description of original monument and accessories and/or subsequent restoration:**

G-13 G.L.O. survey notes 1837 surveyor John Mullett 20" B. Ash N37°E 25 links 9" W. Ash N83°W 10 links	L.C.R.C. Liber 4 Page 232 10-22-81 Cast Iron Monument 10" Oak North 29.70' 30" Oak NE 70.00' 10" Oak South 30.95'
---	--

**B. Description of corner evidence found and/or method applied in restoring or reestablishing corner:**


G-13 Found cast iron Ottawa County Monument  21" Oak South 31' 24" Oak North 29.6'	Accepted position of cast iron monument as a careful perpetuation of the position of the original corner
---	--

P.A. 345 OTTAWA COUNTY  
PEER APPROVED 12/1/97  
*[Signature]*

**C. Description of monument for corner and accessories established to perpetuate locating the position of the corner:**

G-13 Cast Iron Ottawa County Monument

Set Ottawa County Remon tag & nail SE side 21" Twin Oak AZ 193° 31.07'  
 Set Ottawa County Remon tag & nail NW side 10" Oak AZ 230° 43.57'  
 Set Ottawa County Remon tag & nail East side 24" Oak North 29.58'  
 Set Ottawa County Remon tag & nail SE side 36" Oak AZ 51° 50.96'  
 Centerline of East-West road North 0'  
 On centerline of tree ROW to North

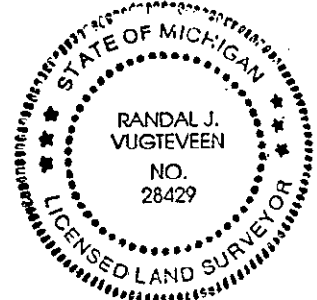

7x7x11 UNICHA \$1.00 PHOTO

Signed by *[Signature]*  
 Surveyor's Michigan License No. 28429

Date Dec 1, 1997