

**SURVEY &
REMONUMENTATION**

MAR 08 1994

COMMISSION

**OTTAWA COUNTY REMONUMENTATION
LAND CORNER RECORDATION CERTIFICATE
Filing Requirement of Act 74, Mich. P.A. 1970**

RECORDED

93 NOV -8 PM 1:58

Elizabeth Sullivan
REGISTER OF DEEDS
OTTAWA COUNTY, MI

For corners in

| | | |
|---------------------------------------|--------------------------|---|
| <u>Ottawa</u> (County) | Located In: | Corner Code # |
| 1. Public Land Survey | T <u>8N</u> R <u>14W</u> | <u>H-3 (N 1/4, 10)</u> <u>Polkton Twp.</u> |
| | T _____ R _____ | _____ |
| | T _____ R _____ | _____ |
| 2. Property Controlling in Section | S _____ T _____ R _____ | _____ |
| | S _____ T _____ R _____ | _____ |
| 3. Miscellaneous Property in Sec. | S _____ T _____ R _____ | _____ |
| | S _____ T _____ R _____ | _____ |
| 4. Lot No. _____, Recorded Plat _____ | | |
| 5. Private Claims _____ | | |

Register of Deeds Stamp & File Number

I, Donald W. Schiele, in a field survey on October 15, 19 93, do hereby certify that under requirements of P.A. 74, Michigan P.A. of 1970, the corner points mentioned in lines 1 and 2 above were in conformance with regulations and rules therefore as required in the current manual of survey instructions of the United States Department of the Interior, Bureau of Land Management or by a decree of a Court of Law and/or that the corner points mentioned in lines 3, 4 and 5 above were in conformance with the rules of the Michigan Board of Land Surveyors or by a Decree of a Court of Law; established, re-established, monumented, re-monumented, recovered, found as expressed below:

| | | | | | | | | | | | |
|----|----|----|----|----|----|----|---|---|---|---|---|
| A | B | C | D | E | F | G | H | I | J | K | L |
| 2 | 6 | 5 | 4 | 3 | 2 | 1 | | | | | |
| 3 | | | | | | | | | | | |
| 4 | 7 | 8 | 9 | 10 | 11 | 12 | | | | | |
| 5 | | | | | | | | | | | |
| 6 | 18 | 17 | 16 | 15 | 14 | 13 | | | | | |
| 7 | | | | | | | | | | | |
| 8 | 19 | 20 | 21 | 22 | 23 | 24 | | | | | |
| 9 | | | | | | | | | | | |
| 10 | 30 | 29 | 28 | 27 | 26 | 25 | | | | | |
| 11 | | | | | | | | | | | |
| 12 | 31 | 32 | 33 | 34 | 35 | 36 | | | | | |
| 13 | | | | | | | | | | | |

NOTE: Not more than 4 corners, all in the same town and range, may be recorded on this certificate.

A. Description of original monument and accessories and/or subsequent restoration:

| | |
|---|--|
| H-3 corner common to Sections 3 and 10 Polkton Twp. | L.C.R.C. recorded in Liber 4, Page 112, 10-14-80 |
| L.C.R.C. recorded in Liber 4, Page 17 | C.I.M. Inscribed "Section Corner" |
| 3/4" Round Iron 12-23-80 | Power Pole NW. 83.53 |
| Nail in NW side 24" Maple NE. 47.65 | 26" Maple NE. 47.75 |
| PK in SW side P. Pole NW. 83.49 | Street Sign SE. 35.52 |
| CL Street Sign SE. 32.71 | Stop Sign SW. 39.02 |

B. Description of corner evidence found and/or method applied in restoring or reestablishing corner:

H-3
Found C.I.M. with top section gone and accepted as a careful and faithful perpetuation of the position of the original corner.
Found PK nail in SW side of Power Pole NW 83.56'
Found nail and tag #18435 in SW side of Power Pole NW 83.50'
CL Street Sign SE 33.00'
CL Stop sign SW 38.95'


C. Description of monument for corner and accessories established to perpetuate locating the position of the corner:

H-3 C.I.M. with top section gone 3" below surface
Set Ottawa County Remon Tag & nail in NW side of 18" Maple N28°E 70.83'
Set Ottawa County Remon Tag & nail in SE side of 21" Pine N56°E 61.06'
CL Street Sign S47°E 33.00'
CL Stop Sign S64°W 38.95'
Set Ottawa County Remon Tag & nail in North side of Power Pole S69°W 81.61'
Set Ottawa County Remon Tag & nail in SW side of Power Pole N45°W 83.58'
CL North and South gravel road 2' West
CL East and West gravel road 1' South

Signed by Donald W. Schiele

Date 10-18-93

Surveyor's Michigan License No. 23517

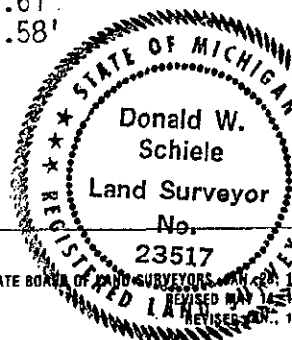

FORM APPROVED BY MICHIGAN STATE BOARD OF LAND SURVEYORS, REVISED MAY 1988