

SURVEY & REMONUMENTATION

NOV 10 1993

COMMISSION

**OTTAWA COUNTY REMONUMENTATION
LAND CORNER RECORDATION CERTIFICATE
Filing Requirement of Act 74, Mich. P.A. 1970**

RECORDED

1993 SEP 29 PM 3:14


For corners in

<u>Ottawa</u> (County)	Located In:	Corner Code #:
1. Public Land Survey	T <u>8N</u> R <u>14W</u>	<u>H-5 (S 1/4, 10)</u> <u>Polkton Twp.</u>
	T _____ R _____	_____
	T _____ R _____	_____
	T _____ R _____	<u>#1</u>
2. Property Controlling in Section	S _____ T _____ R _____	_____
	S _____ T _____ R _____	_____
3. Miscellaneous Property in Sec.	S _____ T _____ R _____	_____
	S _____ T _____ R _____	_____
4. Lot No. _____, Recorded Plat _____		
5. Private Claims _____		

Debbie Johnson
REGISTER OF DEEDS
OTTAWA COUNTY, MI

Register of Deeds Stamp & File Number

I, Donald W. Schiele in a field survey on Sept. 16, 19 93, do hereby certify that under requirements of P.A. 74, Michigan P.A. of 1970, the corner points mentioned in lines 1 and 2 above were in conformance with regulations and rules therefore as required in the current manual of survey instructions of the United States Department of the Interior, Bureau of Land Management or by a decree of a Court of Law and/or that the corner points mentioned in lines 3, 4 and 5 above were in conformance with the rules of the Michigan Board of Land Surveyors or by a Decree of a Court of Law; established, re-established, monumented, re-monumented, recovered, found as expressed below:

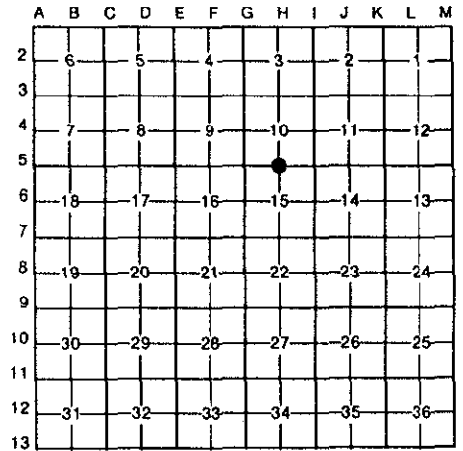

NOTE: Not more than 4 corners, all in the same town and range, may be recorded on this certificate.

A. Description of original monument and accessories and/or subsequent restoration:
 H-5 corner common to Sections 10 and 15 Polkton Twp.
 L.C.R.C. recorded in Liber 4, Page 221 L.C.R.C. recorded in Liber 5, Page 174
 1/4" iron on CL of road to East C.I.M.
 1' W of CL of North & South road St. Sign SE. 41.85'
 Nail in 16" Maple NW. 71.61 6" Ash WNW. 40.89'
 Nail in T. Pole E-SE. 125.20 16" Maple NW. 71.57'
 Center St. sign post W-SW. 30.70 Stump NE. 52.71'

B. Description of corner evidence found and/or method applied in restoring or reestablishing corner:
 H-5
 Found C.I.M. Inscribed "Section Corner" and accepted as a careful and faithful perpetuation of the position of the original corner.
 Found PK nail in North side of Power Pole ESE 125.23'
 CL Street Sign SE 41.95'
 CL 12" Ash WNW 40.8'
 CL North and South gravel road East 1'
 On CL gravel road to East

C. Description of monument for corner and accessories established to perpetuate locating the position of the corner:
 H-5
 C.I.M. 2" below surface
 Set nail and Ottawa Co. re-mon. tag in North side of Power Pole S80°E 125.24'
 Set nail and Ottawa Co. re-mon. tag in West side of 5" Elm S17°E 104.85'
 Set nail and Ottawa Co. re-mon. tag in SW side of 12" Ash N69°W 40.86'
 Set nail and Ottawa Co. re-mon. tag in SW side of Power Pole N37°W 250.30' (E)
 CL North and South gravel road East 1'
 On CL gravel road to East, on CL trail to West

Signed by Donald W. Schiele Date Sept. 20, 1993
 Surveyor's Michigan License No. 23517

