

APR 05 1996

OTTAWA COUNTY REMONUMENTATION
COMMISSION LAND CORNER RECORDATION CERTIFICATE

Filing Requirement of Act 74, Mich. P.A. 1970

For corners in
Ottawa Located In: Corner Code #
(County)

1. Public Land Survey T8N R14W H-7
T R S 1/4 cor. Sec.
T R 15, Polkton Twp.
T R

2. Property Controlling S T R
in Section S T R

3. Miscellaneous S T R
Property in Sec. S T R

4. Lot No. Recorded Plat

5. Private Claims

RECORDED

95 DEC 12 AM 11:50

Register of Deeds
REGISTER OF DEEDS
OTTAWA COUNTY, MI

Register of Deeds Stamp & File Number

I, Steven Lampen, in a field survey on November 15 1995, do hereby certify that under requirements of P.A. 74, Michigan P.A. of 1970, the corner points mentioned in lines 1 and 2 above were in conformance with regulations and rules therefore as required in the current manual of survey instructions of the United States Department of the Interior, Bureau of Land Management or by a decree of a Court of Law and/or that the corner points mentioned in lines 3, 4 and 5 above were in conformance with the rules of the Michigan Board of Land Surveyors or by a Decree of a Court of Law; established, re-established, monumented, re-monumented, recovered, found as expressed below:

NOTE: Not more than 4 corners, all in the same town and range, may be recorded on this certificate.

A. Description of original monument and accessories and/or subsequent restoration:

	LCRC L 2-P 127 May 7, 1973	LCRC L 2-P 385 Nov. 26, 1973	LCRC L 4-P 108 Oct. 14, 1980
H-7	Found 1" pipe	Found 1" iron	Found iron pipe
GLO Survey Notes	Street sign SE 53.0'	Power pole NE 38.97'	Set cast iron mon.
1837, Surveyor - John Mullett	Power pole NE 38.82'	Street sign SE 53.04'	Power pole NE 48.03'
Set Post	MBT ped. SW 57.7'	MBT Box SW 57.6'	Street sign SE 53.10'
6" Beech S 31° 22 links			Centerline MBT ped. SW 68.07'
24" Beech N 12° W 25 links			

B. Description of corner evidence found and/or method applied in restoring or reestablishing corner:

H-7
Found cast iron monument and accepted it as a careful and faithful perpetuation of the position of original corner.


P.K. in power pole	NE 48.08'	Street sign	SE 53.0'
Center of street sign	SE 53.10'	Power pole	NE 38.82'
Center of MBT ped.	SW 68.07'	Telephone ped.	SW 57.7'

P.A. 345 OTTAWA COUNTY
PEER APPROVED 11/20/95

Robert P. Redwood
RDR

C. Description of monument for corner and accessories established to perpetuate locating the position of the corner:

H-7
Cast iron monument
"X" cut in top of curb S 57° W 45.81'
"X" cut in top of curb N 35° W 43.92'
"X" cut in top of curb N 47° E 42.66'
"X" cut in top of curb S 47° E 46.26'

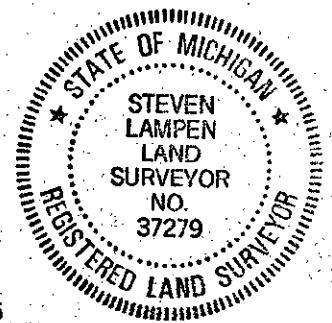

Signed by Steven Lampen Date November 17, 1995

Surveyor's Michigan License No. 37279