

FEB 24 2000

RECORDED

99 OCT 27 PM 1:50

OTTAWA COUNTY REMONUMENTATION
LAND CORNER RECORDATION CERTIFICATE
Filing Requirement of Act 74, Mich. P.A. 1970

SECTION

For corners in

Gary Schiele
REGISTER OF DEEDS
OTTAWA COUNTY MI

<u>Ottawa</u> (County)	Located In:	Corner Code #
1. Public Land Survey	T 8NR 14W	H-11
	T R	(NW, 34)
	T R	Polkton Twp.
	T R	
2. Property Controlling in Section	S T R	
	S T R	
3. Miscellaneous Property in Sec.	S T R	
	S T R	
4. Lot No. _____, Recorded Plat _____		
5. Private Claims _____		

Register of Deeds Stamp & File Number

A	B	C	D	E	F	G	H	I	J	K	L	M
1												
2	6	5	4	3	2	1						
3												
4	7	8	9	10	11	12						
5												
6	18	17	16	15	14	13						
7												
8	19	20	21	22	23	24						
9												
10	30	29	28	27	26	25						
11												
12	31	32	33	34	35	36						
13												

I, Donald W. Schiele, in a field survey on Oct. 8, 1999 do hereby state that under requirements of P.A. 74, Michigan P.A. of 1970, the corner points mentioned in lines 1 and 2 above were in conformance with regulations and rules therefore as required in the current manual of survey instructions of the United States Department of the Interior, Bureau of Land Management or by a decree of a Court of Law and for that the corner points mentioned in lines 3, 4 and 5 above were in conformance with the rules of the Michigan Board of Land Surveyors or by a Decree of a Court of Law; established, re-established, monumented, recovered, found as expressed below:

NOTE: Not more than 2 corners, all in the same town and range, may be recorded on this certificate.

A. Description of original monument and accessories and/or subsequent restoration:

H-11 1/4 corner common to Sections 27 & 34, Polkton Twp.
 Original Government Corner Record: L.C.R.C. recorded in L. 1, P. 701, 10-25-72
 Set qr section post on true line by Francis E. Spicer:
 Beech 20 S83E 22 H-11 3/4" iron
 Hemlock 9 N79W 08 Nail bottle cap in Q MBT pole N65°E 52.7'
 John Mullett, Deputy Surveyor Nail bottle cap in Q CP pole S45°E 51.52'
 April 11, 1837 Nail bottle cap in Q CP pole S60°W 44.20'

(SEE REVERSE)

B. Description of corner evidence found and/or method applied in restoring or reestablishing corner:

H-11 Found 7/8" X 18" Rebar 9" below asphalt surface outside rim of Monument Box and accepted as a careful and faithful perpetuation of the position of the original corner.
 Found nail and bottle cap in SE side of cut off Telephone Pole N62°E 52.78'(E)
 Found nail and bottle cap in NE side of Telephone Pole S46°E 51.52'(E)


10/18/99
GDN

C. Description of monument for corner and accessories established to perpetuate locating the position of the corner:

H-11 Removed 7/8" X 18" Rebar and Monument Box, and replaced with 3/4" X 24" Steel Bar with Ottawa County Remon Cap 2" below asphalt surface in relocated Monument Box.
 Set Ottawa County Remon Tag and nail in SE side of cut off Telephone Pole N62°E 52.70'(E)
 Set Ottawa County Remon Tag and nail in NE side of Power Pole S57°30'E 62.30'(E)
 Set Ottawa County Remon Tag and nail in NW side of Power Pole S47°30'W 50.51'(E)
 Set Ottawa County Remon Tag and nail in South side of Guy Pole N82°30'W 240.06'(E)
 Q of North & South asphalt road 0.3' East
 Q of asphalt road East 4.0' South
 Q of asphalt road West 0.4' South

Receipt #61757

Signed by Donald W. Schiele
Surveyor's Michigan License No. 23517

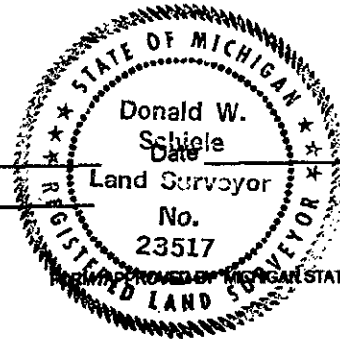

Oct. 18, 1999

Part A., continued:

L.C.R.C. recorded in L. 5, P. 24, 3-4-83 by Arthur W. Brinthall:

H-11

3/4" iron in monument box

NE 52.78' nail & cap in TP
SE 51.52' nail & cap in TP
SW 43.26' PK in N sid of PP
NW 80.41' PK in W side PP 10' high with elec. box

FEB 24 2000

SECTION