

RECORDED

99 OCT 27 PM 1:49

FEB 24 2000

OTTAWA COUNTY REMONUMENTATION
LAND CORNER RECORDATION CERTIFICATE
Filing Requirement of Act 74, Mich. P.A. 1970

Ray Schiele
REGISTER OF DEEDS
OTTAWA COUNTY, MI

SECTION
For corners in

Ottawa Located In: Corner Code #
(County)

1. Public Land Survey T 8 N R 14 W I-2
T R (W/4 2)
T R Polkton Twp.
T R

2. Property Controlling S T R
in Section S T R

3. Miscellaneous S T R
Property in Sec. S T R

4. Lot No. _____, Recorded Plat _____
5. Private Claims _____

Register of Deeds Stamp & File Number

	A	B	C	D	E	F	G	H	I	J	K	L	M
1													
2	6		5		4		3		2		1		
3													
4	7		8		9		10		11		12		
5													
6	18		17		16		15		14		13		
7													
8	19		20		21		22		23		24		
9													
10	30		29		28		27		26		25		
11													
12	31		32		33		34		35		36		
13													

I, Donald W. Schiele, in a field survey on Oct 12, 1999 do hereby state that under requirements of P.A. 74, Michigan P.A. of 1970, the corner points mentioned in lines 1 and 2 above were in conformance with regulations and rules therefore as required in the current manual of survey instructions of the United States Department of the Interior, Bureau of Land Management or by a decree of a Court of Law and for that the corner points mentioned in lines 3, 4 and 5 above were in conformance with the rules of the Michigan Board of Land Surveyors or by a Decree of a Court of Law, established, re-established, monumented, recovered, found as expressed below:

NOTE: Not more than 2 corners, all in the same town and range, may be recorded on this certificate.

A. Description of original monument and accessories and/or subsequent restoration:

I-2 1/4 corner common to Sections 2 & 3, Polkton Twp.
Original Government Corner Record: L.C.R.C. recorded in L. 6, P. 28, 1-3-90
by Thomas E. Joiner:
Hemlock 12 gr section corner Found 1/2" Iron Rod / Set CIM
Beech 12 N37W 12
John Mullett, Deputy Surveyor
April 10, 1837
PP SW 155.88
PP NW 229.31
8" Elm E 64.36

B. Description of corner evidence found and/or method applied in restoring or reestablishing corner:


I-2 Found Cast Iron Monument (broken) 20" below asphalt surface underneath 7/8" X 12" Rebar 10" below asphalt surface and 0.01' South and 0.06' East of Monument. Accepted Cast Iron Monument as a careful and faithful perpetuation of the position of the original corner.
Found nail in NW side of Power Pole S40°30'W 155.92'(E)
Found nail in SW side of Power Pole N30°30'W 229.33'(E)

10/18/99
MS

C. Description of monument for corner and accessories established to perpetuate locating the position of the corner:

I-2 Removed Rebar and Set 3/4" X 17" Steel Bar with Ottawa County Remon Cap 2" below surface of asphalt road in Monument Box over Cast Iron Monument.
Set Ottawa County Remon Tag and nail in West side of SW leg of Power Line Stanchion N02°30'E 634.61' (E)
Set Ottawa County Remon Tag and nail in South side of SW leg of Power Line Stanchion S89°E 566.10' (E)
Set Ottawa County Remon Tag and nail in SE side of Power Pole S40°30'W 155.88' (E)
Set Ottawa County Remon Tag and Nail in NE side of Power Pole N30°30'W 229.47' (E)
Q North and South asphalt road 0.1' East
Q ditch to East 2' North

Signed by Donald W. Schiele
Surveyor's Michigan License No. 23517

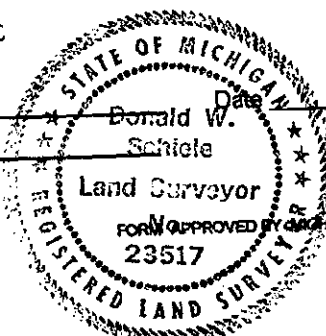

Oct. 18, 1999