

**SURVEY &
REMONUMENTATION**

DEC 01 1993

COMMISSION

OTTAWA COUNTY REMONUMENTATION
LAND CORNER RECORDATION CERTIFICATE
Filing Requirement of Act 74, Mich. P.A. 1970

RECORDED

93 NOV 11 AM 11:55

Phyllis Sultman
REGISTER OF DEEDS
OTTAWA COUNTY, MI

For corners in

<u>Ottawa</u> (County)	Located In:	Corner Code #
1. Public Land Survey	T <u>8N</u> R <u>14W</u>	<u>I-3 (NE, 10)</u> <u>Polkton Twp.</u>
	T _____ R _____	_____
	T _____ R _____	_____
2. Property Controlling in Section	S _____ T _____ R _____	_____
	S _____ T _____ R _____	_____
3. Miscellaneous Property in Sec.	S _____ T _____ R _____	_____
	S _____ T _____ R _____	_____
4. Lot No. _____, Recorded Plat _____		
5. Private Claims _____		

Register of Deeds Stamp & File Number

I, Donald W. Schiele, in a field survey on October 28, 1993, do hereby certify that under requirements of P.A. 74, Michigan P.A. of 1970, the corner points mentioned in lines 1 and 2 above were in conformance with regulations and rules therefore as required in the current manual of survey instructions of the United States Department of the Interior, Bureau of Land Management or by a decree of a Court of Law and/or that the corner points mentioned in lines 3, 4 and 5 above were in conformance with the rules of the Michigan Board of Land Surveyors or by a Decree of a Court of Law; established, re-established, monumented, re-monumented, recovered, found as expressed below:

NOTE: Not more than 4 corners, all in the same town and range, may be recorded on this certificate.

A	B	C	D	E	F	G	H	I	J	K	L	M
2	6	5	4	3	2							
3												
4	7	8	9	10	11	12						
5												
6	18	17	16	15	14	13						
7												
8	19	20	21	22	23	24						
9												
10	30	29	28	27	26	25						
11												
12	31	32	33	34	35	36						
13												

A. Description of original monument and accessories and/or subsequent restoration:

I-3 corner common to Sections 2, 3, 10 and 11 Polkton Twp.
L.C.R.C. recorded in Liber 5, Page 353, 12-06-88.
C.I.M.
PP NW. 116.77
PP SE. 124.49
Centerline St. Sign SW. 53.55
36" Maple ESE. 128.80

B. Description of corner evidence found and/or method applied in restoring or reestablishing corner:

I-3 Found C.I.M. inscribed "Section Corner" in Monument Box and accepted as a careful and faithful perpetuation of the position of the original corner.

Centerline 38" Maple	ESE	129.50'
Found nail in SW side of Power Pole	SE	124.56'
Centerline Street Sign	SW	53.56'
Found nail in NE side of Power Pole	NW	116.81'


C. Description of monument for corner and accessories established to perpetuate locating the position of the corner:

I-3 C.I.M. 5" below surface in Monument Box.

Set Ottawa County Remon Tag & nail in North side of 38" Maple	S79°E	128.91'
Set Ottawa County Remon Tag & nail in SW side of Power Pole	S38°E	124.55'
Set Ottawa County Remon Tag & nail in NW side of 16" White Pine	S68°W	122.27'
Set Ottawa County Remon Tag & nail in NE side of Power Pole	N61°W	116.81'

On Centerline asphalt road North and South
On Centerline gravel road East
Centerline gravel road West 2' North

Signed by Donald W. Schiele Date 10-30-93
Surveyor's Michigan License No. 23517

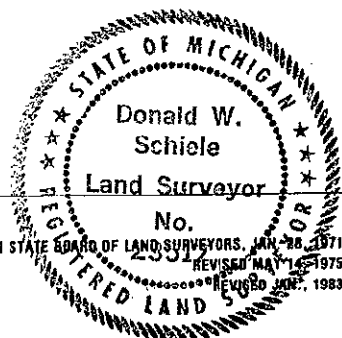

FORM APPROVED BY MICHIGAN STATE BOARD OF LAND SURVEYORS, JAN 28, 1971
REVISED MAY 16, 1975
REVISED JAN 1, 1983