

# SURVEY & REMONUMENTATION

APR 25 1995

COMMISSION

OTTAWA COUNTY REMONUMENTATION  
 LAND CORNER RECORDATION CERTIFICATE  
 Filing Requirement of Act 74, Mich. P.A. 1970

RECORDED

94 DEC -8 PM 12:34

For corners in

<u>Ottawa</u> (County)	Located In:	Corner Code #
1. Public Land Survey	T <u>8N</u> R <u>14W</u>	<u>I-11 (NW, 35)</u> <u>Polkton Twp.</u>
	T _____ R _____	_____
	T _____ R _____	_____
	T _____ R _____	_____
2. Property Controlling in Section	S _____ T _____ R _____	_____
	S _____ T _____ R _____	_____
3. Miscellaneous Property in Sec.	S _____ T _____ R _____	_____
	S _____ T _____ R _____	_____
4. Lot No. _____, Recorded Plat _____		
5. Private Claims _____		

*Phyllis Cushman*  
 REGISTER OF DEEDS  
 OTTAWA COUNTY, MI

Register of Deeds Stamp & File Number

A	B	C	D	E	F	G	H	I	J	K	L	M
2	6	5	4	3	2	1						
3												
4	7	8	9	10	11	12						
5												
6	18	17	16	15	14	13						
7												
8	19	20	21	22	23	24						
9												
10	30	29	28	27	26	25						
11												
12	31	32	33	34	35	36						
13												

I, Donald W. Schiele, in a field survey on November 19, 19 94 do hereby certify that under requirements of P.A. 74, Michigan P.A. of 1970, the corner points mentioned in lines 1 and 2 above were in conformance with regulations and rules therefor as required in the current manual of survey instructions of the United States Department of the Interior, Bureau of Land Management or by a decree of a Court of Law and/or that the corner points mentioned in lines 3, 4 and 5 above were in conformance with the rules of the Michigan Board of Land Surveyors or by a Decree of a Court of Law; established, re-established, monumented, re-monumented, recovered, found as expressed below:

**NOTE: Not more than 4 corners, all in the same town and range, may be recorded on this certificate.**

A. Description of original monument and accessories and/or subsequent restoration:  
 I-11 Corner common to Sections 26, 27, 34 & 35, Polkton Twp.

Original Government Corner Record: L.C.R.C. recorded in Liber 3, Page 336, 2-20-79  
 Set corner post Sec. 26, 27, 34, 35. Found 1" Pipe  
 Post SE. 38.00' P.P.  
 Sugar 9 S22W 14 S. 50.97' 16" Oak  
 Do 9 S56E 11 SW. 62.43" 8" Pear  
 John Mullett, Deputy Surveyor N. 30.45' T.P.  
 April 9, 1837

(SEE REVERSE)

3. Description of corner evidence found and/or method applied in restoring or reestablishing corner:

I-11 Found Cast Iron Monument (broken), 8 1/2" below surface in Monument Box, and accepted as a careful and faithful perpetuation of the position of the original corner.  
 Found nail in NE side of Power Pole S36°30'E 37.95'  
 Found nail in SW side of Power Pole S36°30'E 37.80'  
 Centerline 22" Oak stump S03°30'E 50.8'  
 Centerline 42" Willow stump S42°W 87.5'  
 Found nail in West side of Telephone Pole N02°W 30.52'  
 Found nail in East side of Telephone Pole N02°W 30.45'


*Robert P. Redwood*  
 P.A. 345 OTTAWA COUNTY  
 PEER APPROVED 11/21/94

C. Description of monument for corner and accessories established to perpetuate locating the position of the corner:

I-11 Broken Cast Iron Monument, 8 1/2" below surface in Monument Box.  
 Set Ottawa County Remon Tag & nail in NE side of Power Pole S36°30'E 40.64'  
 Set Ottawa County Remon Tag & nail in NW side of 11" Aspen S30°30'W 152.17'  
 Set Ottawa County Remon Tag & nail in North side of Power Pole S82°30'W 266.90'  
 Set Ottawa County Remon Tag & nail in East side of Telephone Pole N02°W 30.48'  
 Centerline asphalt road East & West, 1' North

Signed by Donald W. Schiele  
 Surveyor's Michigan License No. 23517

Date Nov. 21, 1994

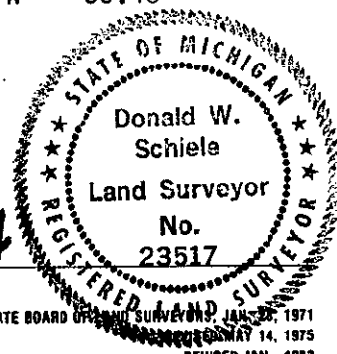

PART A. continued:

L.C.R.C. recorded in Liber 5, Page 23, 3-4-83

I-11

1" Pipe

SE 38.0' to PP

S 50.97' to PK in W side of 16" Oak

N 30.45' to TP

SW 87.90' to PK in NW side quad 10" Willow

L.C.R.C. recorded in Liber 5, Page 128, 6-27-84

I-11 Set CIM

PP SE 37.80'

18" Oak S 50.77'

24" Willow SW 87.57'

Guy Pole N 30.55'

*See page 207.*

*Handwritten scribble*

CODE #  
CORNER  
DATE #

*Handwritten scribble*