

SURVEY & REMONUMENTATION

APR 24 1995

**OTTAWA COUNTY REMONUMENTATION
LAND CORNER RECORDATION CERTIFICATE
Filing Requirement of Act 74, Mich. P.A. 1970**

RECORDED

94 DEC 15 AM 11:52

COMMISSION

For corners in

Ottawa
(County)

Located In:

Corner Code #

- | | | |
|---------------------------------------|--------------------------|---|
| 1. Public Land Survey | T <u>8N</u> R <u>14W</u> | <u>I-12 (W$\frac{1}{4}$, 35)</u> |
| | T _____ R _____ | <u>Polkton Twp.</u> |
| | T _____ R _____ | _____ |
| | T _____ R _____ | _____ |
| 2. Property Controlling in Section | S _____ T _____ R _____ | _____ |
| | S _____ T _____ R _____ | _____ |
| 3. Miscellaneous Property in Sec. | S _____ T _____ R _____ | _____ |
| | S _____ T _____ R _____ | _____ |
| 4. Lot No. _____, Recorded Plat _____ | | |
| 5. Private Claims _____ | | |

Polkton
REGISTER OF DEEDS
OTTAWA COUNTY, MI

Register of Deeds Stamp & File Number

I, Donald W. Schiele, in a field survey on December 5, 19 94, do hereby certify that under requirements of P.A. 74, Michigan P.A. of 1970, the corner points mentioned in lines 1 and 2 above were in conformance with regulations and rules therefore as required in the current manual of survey instructions of the United States Department of the Interior, Bureau of Land Management or by a decree of a Court of Law and/or that the corner points mentioned in lines 3, 4 and 5 above were in conformance with the rules of the Michigan Board of Land Surveyors or by a Decree of a Court of Law; established, re-established, monumented, re-monumented, recovered, found as expressed below:

	A	B	C	D	E	F	G	H	I	J	K	L	M
2	6	5	4	3	2	1							
3													
4	7	8	9	10	11	12							
5													
6	18	17	16	15	14	13							
7													
8	19	20	21	22	23	24							
9													
10	30	29	28	27	26	25							
11													
12	31	32	33	34	35	36							

NOTE: Not more than 4 corners, all in the same town and range, may be recorded on this certificate.


A. Description of original monument and accessories and/or subsequent restoration:
I-12 $\frac{1}{4}$ corner common to Sections 34 & 35, Polkton Twp.

Original Government Corner Record:	L.C.R.C. recorded in Liber 2, Page 815, 9-11-75
Set qr section post between Sec. 34 & 35.	Iron
Post	First fence post South of corner S 27.00'
Beech 8 S13W .25	PK nail in corner fence post S 1.00'
Do 6 N17E 04	PK nail in 24" Oak WNW 16.30'
John Mullett, Deputy Surveyor	
April 9, 1837	

(SEE REVERSE)

B. Description of corner evidence found and/or method applied in restoring or reestablishing corner:
I-12 Found Cast Iron Monument inscribed "Section Corner", at surface leaning North 0.4'.
Straightened, and accepted as a careful and faithful perpetuation of the position of the original corner.
Found Fence Post on ground with nail and Cap # 23520. Centerline base East 45.5'
Found Fence Post on ground with nail and Cap # 23520. Centerline base South 27.0'

PEER APPROVED 12/12/94
Arday P. Hedewell

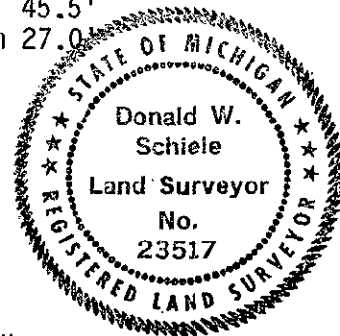

C. Description of monument for corner and accessories established to perpetuate locating the position of the corner:
I-12 Cast Iron Monument inscribed "Section Corner", at surface.
Set Ottawa County Remon Tag & nail in NW side of 3" Cherry N56°E 304.56' (E)
Set Ottawa County Remon Tag & nail in North side of 12" Elm S88°30'E 108.18' (E)
Set Ottawa County Remon Tag & nail in West side of 15" Elm South 450.59' (C)
Set Ottawa County Remon Tag & nail in NE side of 10" Elm N26°W 291.78' (E)
On fence line to South, ±
Fence line to East, 1'± South

Signed by Donald W. Schiele Date DEC. 12, 1994
Surveyor's Michigan License No. 23517

PART A. continued:

L.C.R.C. recorded in Liber 4, Page 51, 4-14-80

I-12

Set Cast Iron Monument Inscribed "Section Corner"

Ties Taken:

Set Tie Nail in Sd. of 4"x4" Wood Fence Post	South	27.00'
Set Tie Nail in Sd. of Wood Fence Post	East	45.47'
Set Tie Nail in Sd. of 25" White Oak	WNW	16.80'
Set Tie Nail in Sd. of 15" Hickory	West	39.66'

L.C.R.C. recorded in Liber 5, Page 26, 3-4-83

I-12

cast monument

S 27.0' to PK nail in side of 4"x4" wood fence post
E 45.47' to PK nail in side of wood fence post