

SURVEY & REMONUMENTATION

APR 25 1995

OTTAWA COUNTY REMONUMENTATION
LAND CORNER RECORDATION CERTIFICATE 94 DEC -8 PM 12: 34
 Filing Requirement of Act 74, Mich. P.A. 1970

COMMISSION

or corners in

Register of Deeds
 REGISTER OF DEEDS
 OTTAWA COUNTY, MI

<u>Ottawa</u> (County)	Located in:	Corner Code #
Public Land Survey	T <u>8N</u> R <u>14W</u>	<u>I-13 (SW, 35)</u> <u>Polkton Twp.</u>
	T _____ R _____	_____
	T _____ R _____	_____
Property Controlling in Section	S _____ T _____ R _____	_____
Miscellaneous	S _____ T _____ R _____	_____
Property in Sec.	S _____ T _____ R _____	_____

Register of Deeds Stamp & File Number

Lot No. _____, Recorded Plat _____
 Private Claims _____

	A	B	C	D	E	F	G	H	I	J	K	L	M
2	6	5	4	3	2	1							
3													
4	7	8	9	10	11	12							
5													
6	18	17	16	15	14	13							
7													
8	19	20	21	22	23	24							
9													
10	30	29	28	27	26	25							
11													
12	31	32	33	34	35	36							
13													

Donald W. Schiele, in a field survey on November 19, 19 94,
 hereby certify that under requirements of P.A. 74, Michigan P.A. of 1970, the corner points mentioned in lines 1 and 2 above were in conformance with regulations and rules therefore as required in the current manual of survey instructions of the United States Department of the Interior, Bureau of Land Management or by a decree of a Court of Law and/or that the corner points mentioned in lines 3, 4 and 5 above were in conformance with the rules of the Michigan Board of Land Surveyors or by a Decree of a Court of Law; established, re-established, monumented, re-monumented, recovered, found as expressed below:

OTE: Not more than 4 corners, all in the same town and range, may be recorded on this certificate.

Description of original monument and accessories and/or subsequent restoration:
I-13 SW corner, Section 35 & SE corner, Section 34, Polkton Twp.
 Original Government L.C.R.C. recorded in Liber 3, L.C.R.C. recorded in Liber 4,
 Corner Record: Page 139; 11-29-76 Page 231, 10-22-81
 Set corner post Found 1" Pipe Set Cast Iron Monument
 Sec. 34 & 35 NW 35.48' 18" Hickory 18" Hickory NW 35.51'
 Post NE 37.45' C/L 2" Maple 4" Maple NNE 37.45'
 Beech 9 N16E 31 3" Maple NE 62.65'
 Do 9 N43W 34

(SEE REVERSE)

Description of corner evidence found and/or method applied in restoring or reestablishing corner:
I-13 Found Cast Iron Monument inscribed "Section Corner", 3 1/2" below surface,
 and accepted as a careful and faithful perpetuation of the position of the original corner.

Centerline 8" Maple	N40°30'E	37.4'
Centerline 5" Maple	N63°30'E	62.7'
Found nail in SW side of 22" Hickory	N35°30'W	35.48'


PA 345 OTTAWA COUNTY
 PEER APPROVED 11/21/94

Description of monument for corner and accessories established to perpetuate locating the position of the corner:
I-13 Cast Iron Monument inscribed "Section Corner", 3 1/2" below surface.

SW corner, brick face to House # 6365	N18°E	160.13'
Set Ottawa County Remon Tag & nail in SE side of 8" Maple	N40°30'E	37.40'
Set Ottawa County Remon Tag & nail in SE side of 8" Maple	N73°E	93.35'
Set Ottawa County Remon Tag & nail in West side of 6"X6" Wood Post	S10°30'E	26.22'
Set Ottawa County Remon Tag & nail in SW side of 22" Hickory	N35°30'W	35.55'
On occupation line to North ±		
Occupation line to South, 7' East ±		
Centerline gravel road East & West, 3' South		

Signed by Donald W. Schiele
 Surveyor's Michigan License No. 23517

Date Nov. 21, 1994

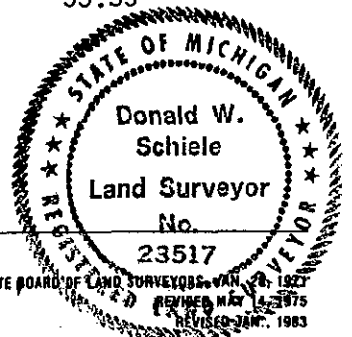

FORM APPROVED BY MICHIGAN STATE BOARD OF LAND SURVEYORS, JAN. 28, 1927
 REVISED MAY 14, 1975
 REVISED JAN. 1983

PART A. continued:

L.C.R.C. recorded in Liber 5, Page 26, 3-4-83
I-13

Cast monument

NW 35.51' to nail & washer in SW side 18" Hickory

NNE 37.45' to C/L 4" Maple

NE 62.65' to C/L 3" Maple

N 30.22' to PK in W side of 4"x4" wood post