

SURVEY & REMONUMENTATION

MAR 08 1994

COMMISSION

**OTTAWA COUNTY REMONUMENTATION
LAND CORNER RECORDATION CERTIFICATE
Filing Requirement of Act 74, Mich. P.A. 1970**

RECORDED

93 NOV -8 PM 1:58

Deborah Kullman
REGISTER OF DEEDS
OTTAWA COUNTY, MI

For corners in

Ottawa

(County)

Located In:

Corner Code ##

- | | | |
|------------------------------------|--------------------------|----------------------|
| 1. Public Land Survey | T <u>8N</u> R <u>14W</u> | <u>J-5 (S ¼, 11)</u> |
| | T _____ R _____ | <u>Polkton Twp.</u> |
| | T _____ R _____ | _____ |
| | T _____ R _____ | _____ |
| 2. Property Controlling in Section | S _____ T _____ R _____ | _____ |
| | S _____ T _____ R _____ | _____ |
| 3. Miscellaneous Property in Sec. | S _____ T _____ R _____ | _____ |
| | S _____ T _____ R _____ | _____ |

Register of Deeds Stamp & File Number

4. Lot No. _____, Recorded Plat _____
5. Private Claims _____

	A	B	C	D	E	F	G	H	I	J	K	L
2	6		5		4		3		2		1	
3												
4	7		8		9		10		11		12	
5									●			
6	18		17		16		15		14		13	
7												
8	19		20		21		22		23		24	
9												
10	30		29		28		27		26		25	
11												
12	31		32		33		34		35		36	
13												

I, Donald W. Schiele, in a field survey on October 16th, 19 93, do hereby certify that under requirements of P.A. 74, Michigan P.A. of 1970, the corner points mentioned in lines 1 and 2 above were in conformance with regulations and rules therefore as required in the current manual of survey instructions of the United States Department of the Interior, Bureau of Land Management or by a decree of a Court of Law and/or that the corner points mentioned in lines 3, 4 and 5 above were in conformance with the rules of the Michigan Board of Land Surveyors or by a Decree of a Court of Law; established, re-established, monumented, re-monumented, recovered, found as expressed below:

NOTE: Not more than 4 corners, all in the same town and range, may be recorded on this certificate.

A. Description of original monument and accessories and/or subsequent restoration:

J-5 corner common to Sections 11 and 14 Polkton Twp.	L.C.R.C. recorded in Liber 4, Page 110, 10-14-80
L.C.R.C. recorded in Liber 1, Page 201	C.I.M. Inscribed "Section Corner"
1" Iron 12-23-71	
Fe Post N00° 25.1'	Fence Post N 21.00
Fe Post S00° 20.12'	Fence Post SE 25.58
Fe Post N63W° 39.30'	4" Apple NW 26.55

In centerline road on fe lines N&S

B. Description of corner evidence found and/or method applied in restoring or reestablishing corner:

J-5
Found C.I.M. with top section gone and accepted as a careful and faithful perpetuation of the position of the original corner.
Found nail in East side of Fence Post leaning North North 21.89'
Found nail and tag in NE side of 12" Apple NW 26.91'
Found Capped Steel Bar #18435 S0°W 32.92'


C. Description of monument for corner and accessories established to perpetuate locating the position of the corner:

J-5
C.I.M. with top section gone at road surface
Set Ottawa County Remon Tag & nail in NW side of 6" Maple N9°E 38.53'
Capped Steel Bar #18435 S0°W 32.92'
Set Ottawa County Remon Tag & nail in North side of Power Pole S77°W 253.50' (E)
Set Ottawa County Remon Tag & nail in SW side of 12" Apple N37°W 26.88'
On occupation lines North and South
On CL East and West gravel road

Signed by Donald W. Schiele

Date 10-18-93

Surveyor's Michigan License No. 23517

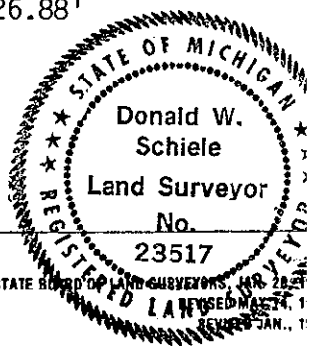

FORM APPROVED BY MICHIGAN STATE BOARD OF LAND SURVEYORS, MAR 28 21
REVISED JAN. 1