

**SURVEY &
REMONUMENTATION**

DEC 0 1 1993

COMMISSION

OTTAWA COUNTY REMONUMENTATION
LAND CORNER RECORDATION CERTIFICATE
Filing Requirement of Act 74, Mich. P.A. 1970

RECORDED

93 NOV 11 AM 11:55

Polkton
REGISTER OF DEEDS
OTTAWA COUNTY, MI

For corners in

Ottawa (County)	Located In:	Corner Code #
1. Public Land Survey	T <u>8N</u> R <u>14W</u>	<u>K-4 (E 1/4, 11)</u> <u>Polkton Twp.</u>
	T _____ R _____	_____
	T _____ R _____	_____
	T _____ R _____	_____
2. Property Controlling in Section	S _____ T _____ R _____	_____
	S _____ T _____ R _____	_____
3. Miscellaneous Property in Sec.	S _____ T _____ R _____	_____
	S _____ T _____ R _____	_____

Register of Deeds Stamp & File Number

4. Lot No. _____, Recorded Plat _____
5. Private Claims _____

	A	B	C	D	E	F	G	H	I	J	K	L	M
2	6	5	4	3	2	1							
3													
4	7	8	9	10	11	12							
5													
6	18	17	16	15	14	13							
7													
8	19	20	21	22	23	24							
9													
10	30	29	28	27	26	25							
11													
12	31	32	33	34	35	36							
13													

I, Donald W. Schiele in a field survey on November 2, 19 93, do hereby certify that under requirements of P.A. 74, Michigan P.A. of 1970, the corner points mentioned in lines 1 and 2 above were in conformance with regulations and rules therefore as required in the current manual of survey instructions of the United States Department of the Interior, Bureau of Land Management or by a decree of a Court of Law and/or that the corner points mentioned in lines 3, 4 and 5 above were in conformance with the rules of the Michigan Board of Land Surveyors or by a Decree of a Court of Law; established, re-established, monumented, re-monumented, recovered, found as expressed below:

NOTE: Not more than 4 corners, all in the same town and range, may be recorded on this certificate.

A. Description of original monument and accessories and/or subsequent restoration:

K-4 corner common to Sections 11 and 12 Polkton Twp.		L.C.R.C. recorded in Liber 3, Page 233, 12-21-77.	
L.C.R.C. recorded in Liber 2, Page 783.		C.I.M. Inscribed "Ottawa County Section Corner"	
Angle Iron over Steel Bar	5-5-75.	Tack in Hub	NE. 55.31
Fe. Post	E. 33.77'	Power Pole	SE. 51.63
24" Oak	NW. 34.80'	Power Pole	W. 71.04
P. Pole	SE. 51.61'		
P. Pole	W. 71.07'		

B. Description of corner evidence found and/or method applied in restoring or reestablishing corner:

K-4 Found C.I.M. inscribed "Ottawa County Section Corner" in Monument Box and accepted as a careful and faithful perpetuation of the position of the original corner.

Found Tag # 14091 and nail in NE side of Power Pole	SE	51.59'
Found Tag # 14091 and nail in South side of Power Pole	West	71.09'

C. Description of monument for corner and accessories established to perpetuate locating the position of the corner:


K-4 C.I.M. inscribed "Ottawa County Section Corner" 7" below surface in Monument Box.

Set Ottawa County Remon Tag & nail in SW side of Power Pole	S52°E	51.86'
Set Ottawa County Remon Tag & nail in SW side of 10" Maple	S29°E	93.91'
Set Ottawa County Remon Tag & nail in SE side of Power Pole	S29°W	268.92' (E)
Set Ottawa County Remon Tag & nail in South side of Power Pole	S90°W	71.09'

On Centerline North and South asphalt road
On fence lines East and West

Signed by Donald W. Schiele
Surveyor's Michigan License No. 23517

Date Nov. 8, 1993

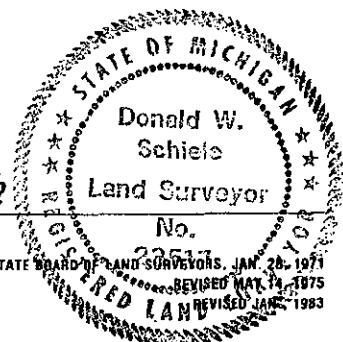

FORM APPROVED BY MICHIGAN STATE BOARD OF LAND SURVEYORS, JAN. 28, 1971
REVISED MAY 14, 1975
REVISED JAN. 1983