

**SURVEY & REMONUMENTATION**

APR 25 1995

**COMMISSION**

For corners in

Ottawa  
(County)

Located In:

Corner Code #

- |                                       |                          |                              |
|---------------------------------------|--------------------------|------------------------------|
| 1. Public Land Survey                 | T <u>8N</u> R <u>14W</u> | K-7 (NW, 24)<br>Polkton Twp. |
|                                       | T _____ R _____          | _____                        |
|                                       | T _____ R _____          | _____                        |
|                                       | T _____ R _____          | _____                        |
| 2. Property Controlling in Section    | S _____ T _____ R _____  | _____                        |
|                                       | S _____ T _____ R _____  | _____                        |
| 3. Miscellaneous Property in Sec.     | S _____ T _____ R _____  | _____                        |
|                                       | S _____ T _____ R _____  | _____                        |
| 4. Lot No. _____, Recorded Plat _____ |                          |                              |
| 5. Private Claims _____               |                          |                              |

RECORDED

OTTAWA COUNTY REMONUMENTATION  
LAND CORNER RECORDATION CERTIFICATE 94 DEC -8 PM 12:34  
Filing Requirement of Act 74, Mich. P.A. 1970

*Richard R. Anderson*  
REGISTER OF DEEDS  
OTTAWA COUNTY, MI

Register of Deeds Stamp & File Number

A	B	C	D	E	F	G	H	I	J	K	L	M
2	6	5	4	3	2	1						
3												
4	7	8	9	10	11	12						
5												
6	18	17	16	15	14	13						
7												
8	19	20	21	22	23	24						
9												
10	30	29	28	27	26	25						
11												
12	31	32	33	34	35	36						
13												

I, Donald W. Schiele, in a field survey on November 15, 19 94, do hereby certify that under requirements of P.A. 74, Michigan P.A. of 1970, the corner points mentioned in lines 1 and 2 above were in conformance with regulations and rules therefore as required in the current manual of survey instructions of the United States Department of the Interior, Bureau of Land Management or by a decree of a Court of Law and/or that the corner points mentioned in lines 3, 4 and 5 above were in conformance with the rules of the Michigan Board of Land Surveyors or by a Decree of a Court of Law; established, re-established, monumented, re-monumented, recovered, found as expressed below:

**NOTE: Not more than 4 corners, all in the same town and range, may be recorded on this certificate.**


A. Description of original monument and accessories and/or subsequent restoration:  
K-7 corner common to Sections 13, 14, 23 & 24, Polkton Twp.  
Original Government Corner Record: L.C.R.C. recorded in Liber 1, Page 201, 12-23-71  
Set corner post Sec. 13, 14, 23, 24 BT Spike in centerline roads  
Post CP Pole N12°W 96.67'  
Elm 24 S45W .05 MBT Pole S38°W 43.15'  
Beech 10 N39E 30 MBT Pole S65°E 68.03' (SEE REVERSE)  
John Mullett, Deputy Surveyor MBT Pole N25°E 70.55'  
April 8, 1837

B. Description of corner evidence found and/or method applied in restoring or reestablishing corner:  
K-7 Found Cast Iron Monument inscribed "Ottawa County Section Corner", 5" below surface in Monument Box, and accepted as a careful and faithful perpetuation of the position of the original corner.  
Centerline Catch Basin S57°W 54.27'  
Found PK nail & washer in East side of Power Pole N15°30'W 99.92'

C. Description of monument for corner and accessories established to perpetuate locating the position of the corner:  
K-7 Cast Iron Monument inscribed "Ottawa County Section Corner", 5" below surface in Monument Box.  
Set Ottawa County Remon Tag & nail in NE side of 24" Aspen N45°E 95.92'  
Set Ottawa County Remon Tag & nail in SW side of 11" Ash S44°30'E 76.34'  
Face of Lift Station Manhole S28°W 72.31'  
Centerline Catch Basin S57°W 54.27'  
Southeast corner, foundation to House # 15 N52°W 117.41'  
Set Ottawa County Remon Tag & nail in East side of Power Pole N15°30'W 99.86'  
On centerline asphalt roads North, South & West  
Centerline asphalt road East, 3' North

P.A. 345 OTTAWA COUNTY  
PEER APPROVED 11/21/94  
*Harvey P. McDowell*

Signed by Donald W. Schiele Date Nov 18, 1994  
Surveyor's Michigan License No. 23517

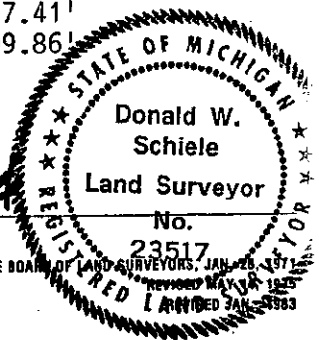

FORM APPROVED BY MICHIGAN STATE BOARD OF LAND SURVEYORS, JAN. 26, 1971, REVISED MAY 18, 1983, L.A. 11/28/83

PART A. continued:

L.C.R.C. recorded in Liber 2, Page 349, 10-31-73

K-7

Set ½" iron (in place of PK)

CL catch basin	S50°W	54.32'
Gas marker	N70°W	59.45'
St. sign	N45°E	44.50'
P. pole	N15°W	97.10' - PK nail E side

L.C.R.C. recorded in Liber 3, Page 235, 12-21-77

K-7

Found ½" Iron, Replaced with Cast Iron Monument Inscribed "Ottawa County Section Corner".

Ties:

Gas Marker	N70°W	59.45'
Power Pole	N15°W	97.10'
Street Sign	N45°E	44.50'
CL Catch Basin	S50°W	54.32'

*Supp. of notes*

*Handwritten notes and stamps*

*Vertical stamps and markings*