

**SURVEY & REMONUMENTATION**

APR 25 1995

**OTTAWA COUNTY REMONUMENTATION  
LAND CORNER RECORDATION CERTIFICATE  
Filing Requirement of Act 74, Mich. P.A. 1970**

RECORDED

94 DEC -8 PM 12:34

**COMMISSION**

For corners in

Ottawa  
(County)

Located In:

Corner Code #

- |                                    |   |           |   |            |                     |
|------------------------------------|---|-----------|---|------------|---------------------|
| 1. Public Land Survey              | T | <u>8N</u> | R | <u>14W</u> | <u>K-9 (SW, 24)</u> |
|                                    | T |           | R |            | <u>Polkton Twp.</u> |
|                                    | T |           | R |            |                     |
|                                    | T |           | R |            |                     |
| 2. Property Controlling in Section | S |           | T | R          |                     |
|                                    | S |           | T | R          |                     |
| 3. Miscellaneous Property in Sec.  | S |           | T | R          |                     |
|                                    | S |           | T | R          |                     |
4. Lot No. \_\_\_\_\_, Recorded Plat \_\_\_\_\_
5. Private Claims \_\_\_\_\_

*Phyllis Williams*  
REGISTER OF DEEDS  
OTTAWA COUNTY, MI

Register of Deeds Stamp & File Number

I, Donald W. Schiele in a field survey on November 18, 19 94, do hereby certify that under requirements of P.A. 74, Michigan P.A. of 1970, the corner points mentioned in lines 1 and 2 above were in conformance with regulations and rules therefore as required in the current manual of survey instructions of the United States Department of the Interior, Bureau of Land Management or by a decree of a Court of Law and/or that the corner points mentioned in lines 3, 4 and 5 above were in conformance with the rules of the Michigan Board of Land Surveyors or by a Decree of a Court of Law; established, re-established, monumented, re-monumented, recovered, found as expressed below:

**NOTE: Not more than 4 corners, all in the same town and range, may be recorded on this certificate.**

	A	B	C	D	E	F	G	H	I	J	K	L	M
2	6	5	4	3	2	1							
3													
4	7	8	9	10	11	12							
5													
6	18	17	16	15	14	13							
7													
8	19	20	21	22	23	24							
9													
10	30	29	28	27	26	25							
11													
12	31	32	33	34	35	36							
13													

A. Description of original monument and accessories and/or subsequent restoration:  
K-9 corner common to Sections 23, 24, 25 & 26, Polkton Twp.  
Original Government L.C.R.C. recorded in Liber 1, Page 711, 10-27-72  
Corner Record: 1" Iron in Mon. Box  
Set corner post Sec. 23, 24, 25, 26. S.W. 43.20 P.P.  
Post N.W. 39.55 P.P.  
Beech 11 S 2W .10 N.E. 59.50 T.P.  
Sugar 8 N37W 45  
John Mullett, Deputy Surveyor  
April 8, 1837

L.C.R.C. recorded in Liber 5, Page 21, 3-4-83  
1 1/2" sq. iron in monument box  
NE 59.35' to nail and washer in SE side T.P.  
NW 66.92' to PK in S side of P.P.  
SW 43.65' to PK in SE side of T.P.  
SSW 47.21' to NW corner of porch to wood stove place


B. Description of corner evidence found and/or method applied in restoring or reestablishing corner:  
K-9 Found 3/4" X 24" square Iron Bar, 8" below surface in Monument Box, and accepted as a careful and faithful perpetuation of the position of the original corner.  
Found PK nail in SE side of Telephone Pole N29°30'E 59.39'  
Found nail & MSHD Tag in SE side of Telephone Pole N29°30'E 59.40'  
NW corner, concrete porch to building S02°W 47.18'  
Found nail in NE side of Power Pole S50°W 43.17'  
Found PK nail in SE side of Power Pole S50°W 43.60'  
Found PK nail in South side of Power Pole N63°30'W 66.99'

**P.A. 345 OTTAWA COUNTY**  
PEER APPROVED 11/21/94

C. Description of monument for corner and accessories established to perpetuate locating the position of the corner:  
K-9 Replaced 3/4" X 24" square Iron Bar with 3/4" X 24" Steel Bar & Ottawa County Remon Cap, 2" below surface in Monument Box.  
SW corner, concrete foundation to South sign leg N46°E 50.23'  
NE corner, concrete porch to building S29°E 52.29'  
Set Ottawa County Remon Tag & nail in NW side of Telephone Pole S47°W 41.16'  
Set Ottawa County Remon Tag & nail in SW side of Power Pole N63°30'W 67.08'  
Centerline Fire Hydrant N30°30'W 51.74'  
On centerline asphalt roads North, East & West  
West line, building to South, 1' West

Signed by Donald W. Schiele  
Surveyor's Michigan License No. 23517

Date Nov. 21, 1994

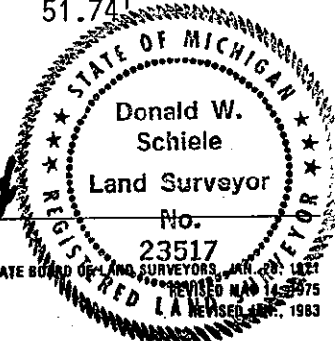

FORM APPROVED BY MICHIGAN STATE BOARD OF LAND SURVEYORS, JAN. 23, 1971  
REVISED MAR 14, 1975  
L.A. REVISED MAR. 1983