

FEB 24 2000

OTTAWA COUNTY REMONUMENTATION

RECORDED

99 JUL 30 PM 12: 26

SECTION

LAND CORNER RECORDATION CERTIFICATE
Filing Requirement of Act 74, Mich. P.A. 1970

Sam Sibley
REGISTER OF DEEDS
OTTAWA COUNTY, MI

For corners in

OTTAWA

(County)

Located In:

Corner Code #

- 1. Public Land Survey T 8N R 14W K-10 W 1/4 Cor Sec
 T R 25 Polkton Twp
 T R _____
 T R _____
- 2. Property Controlling S T R _____
 in Section S T R _____
- 3. Miscellaneous S T R _____
 Property in Sec. S T R _____

Register of Deeds Stamp & File Number

- 4. Lot No. _____, Recorded Plat _____
- 5. Private Claims _____

I, Randal J. Vugteveen, in a field survey on March 16, 1999 do hereby state that under requirements of P.A. 74, Michigan P.A. of 1970, the corner points mentioned in lines 1 and 2 above were in conformance with regulations and rules therefore as required in the current manual of survey instructions of the United States Department of the Interior, Bureau of Land Management or by a decree of a Court of Law and for that the corner points mentioned in lines 3, 4 and 5 above were in conformance with the rules of the Michigan Board of Land Surveyors or by a Decree of a Court of Law; established, re-established, monumented, recovered, found as expressed below.

NOTE: Not more than 2 corners, all in the same town and range, may be recorded on this certificate.

A	B	C	D	E	F	G	H	I	J	K	L	M
1												
2	6		5		4		3		2		1	
3												
4	7		8		9		10		11		12	
5												
6	18		17		16		15		14		13	
7												
8	19		20		21		22		23		24	
9												
10	30		29		28		27		26		25	
11												
12	31		32		33		34		35		36	
13												

A. Description of original monument and accessories and/or subsequent restoration:

K-10 GLO April 1837
 John Mullett D.S.
 Set Post
 6" Beech S66°E 17 Links
 22" Sugar N84°W 19 Links

Liber 1 Page 711
 Englert 1972
 E 1.83' steel fence post
 S 10.50' steel fence post
 WSW 51.90' NE cor headwall

K-10 Liber 4, Page 305
 Joiner 1982
 Set cast iron monument
 N. end chain link fence ESE 3.10'
 2" ash N.W. 17.69'
 2nd fence post south 19.48'

B. Description of corner evidence found and/or method applied in restoring or reestablishing corner:

K-10 found 30" cast iron monument in eroding ditch (very unstable)

NW corner chain link fence post S65°E 3.10'
 NE corner conc headwall S87°W 51.95'
 Center of 8" Ash N45°W 17.7'
 Fence post S2°E 19.6'

Accepted Cast Iron Monument as a careful and faithful perpetuation of the position of the original corner.

Removed Cast Iron Monument, replaced with 3/4" X 36" steel bar with remon cap.


C. Description of monument for corner and accessories established to perpetuate locating the position of the corner:

K-10 3/4" X 36" Steel Bar with Remon Cap

NW cor. 3 1/2" "L" Shaped Fence Post S65°E 3.10'
 NE Cor Conc. Headwall S87°W 51.95'
 West Side Center Of 3rd Fence Post South S2°E 19.59'
 Set Nail And Remon Cap In SW Side 8" ASH N45°W 17.68'

STATE OF MICHIGAN

3/22/99
RJV

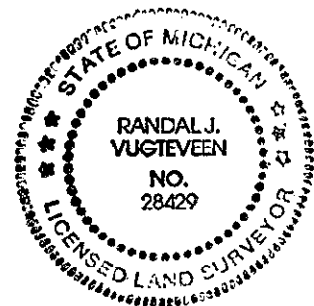

\$9.00 CORNER
Receipt #52389

Signed by *Randal J. Vugteveen*
 Surveyor's Michigan License No. 28429

Date MARCH 16, 1999