

# SURVEY & REMONUMENTATION

APR 25 1995

## OTTAWA COUNTY REMONUMENTATION LAND CORNER RECORDATION CERTIFICATE Filing Requirement of Act 74, Mich. P.A. 1970

RECORDED  
94 DEC -8 PM 12:34

### COMMISSION


For corners in

*Phyllis Williams*  
REGISTER OF DEEDS  
OTTAWA COUNTY, MI

Ottawa (County)	Located In:	Corner Code #
1. Public Land Survey	T <u>8N</u> R <u>14W</u>	K-11 (NW, 36) Polkton Twp.
	T _____ R _____	_____
	T _____ R _____	_____
	T _____ R _____	_____
2. Property Controlling in Section	S _____ T _____ R _____	_____
	S _____ T _____ R _____	_____
3. Miscellaneous Property in Sec.	S _____ T _____ R _____	_____
	S _____ T _____ R _____	_____

Register of Deeds Stamp & File Number

4. Lot No. \_\_\_\_\_, Recorded Plat \_\_\_\_\_  
5. Private Claims \_\_\_\_\_

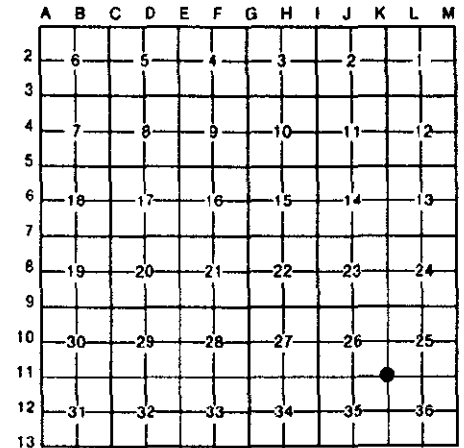

Donald W. Schiele, in a field survey on November 17, 19 94,  
to hereby certify that under requirements of P.A. 74, Michigan P.A. of 1970, the corner points mentioned  
in lines 1 and 2 above were in conformance with regulations and rules therefore as required in the  
current manual of survey instructions of the United States Department of the Interior, Bureau of Land  
Management or by a decree of a Court of Law and/or that the corner points mentioned in lines 3, 4 and 5  
above were in conformance with the rules of the Michigan Board of Land Surveyors or by a Decree of a  
Court of Law, established, re-established, monumented, re-monumented, recovered, found as  
expressed below:

**NOTE: Not more than 4 corners, all in the same town and range, may be recorded on this certificate.**

1. Description of original monument and accessories and/or subsequent restoration:  
K-11 Corner common to Sections 25, 26, 35 & 36, Polkton Twp.  
Original Government L.C.R.C. recorded in Liber 2,  
Corner Record: Page 97, 4-5-73  
Set corner post Sec. 1/2" solid rod  
25, 26, 35, 36. Nail in side guard rail post NE 44.83'  
Post Nail in side guard rail post SE 39.20'  
Sugar 28 S76E 30 Nail in side 16" Maple NW 71.92'

L.C.R.C. recorded in  
Liber 5, Page 128, 6-27-84  
Set CIM  
4" Twin Locust SSW 43.50'  
Nail in Top of W  
Guard Rail Post NE 44.92'  
4" Pine NW 68.57'  
8" Pine NW 66.08'

2. Description of corner evidence found and/or method applied in restoring or reestablishing corner:  
K-11 Found 2-3/4" dia. Cast Iron Monument inscribed "Section Corner", 3 1/2" below surface in  
Monument Box, and accepted as a careful and faithful perpetuation of the position of  
the original corner.

Found nail in side of Guard Rail Post	N65°E	44.91'
Found nail in top of Guard Rail Post	N65°E	44.97'
Found nail in side of Guard Rail Post	S62°E	39.32'
Found PK nail in top of Guard Rail Post	S62°E	39.52'
Found nail & tag in East side of Power Pole	S01°W	63.26'
Found PK nail in NW side of Telephone Pole	S56°30'W	56.91'
Found nail in SW side of 10" Spruce	N32°W	65.96'
Found nail in SW side of 10" Spruce	N32°W	66.27'


P.A. 345 OTTAWA COUNTY  
PEER APPROVED 11/21/94  
*Handwritten signature*

3. Description of monument for corner and accessories established to perpetuate locating the position of the corner:  
K-11 2-3/4" dia. Cast Iron Monument inscribed "Section Corner", 3 1/2" below surface in  
Monument Box.

Set Ottawa County Remon Tag & nail in top of Guard Rail Post	N65°E	44.97'
Set Ottawa County Remon Tag & nail in top of Guard Rail Post	S62°E	39.50'
Set Ottawa County Remon Tag & nail in East side of Power Pole	S01°W	63.26'
Set Ottawa County Remon Tag & nail in NW side of Telephone Pole	S56°30'W	56.89'
Set Ottawa County Remon Tag & nail in SW side of 10" Spruce	N32°W	66.06'
On fence lines North & South		
Centerline asphalt road East & West, 2' South		

Signed by Donald W. Schiele  
Surveyor's Michigan License No. 23517

Date Nov. 18, 1994

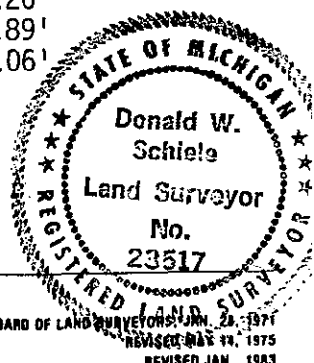

FORM APPROVED BY MICHIGAN STATE BOARD OF LAND SURVEYORS, JAN. 24, 1974  
REVISED MAY 11, 1975  
REVISED JAN., 1983