

FEB 24 2000

RECORDED

99 SEP -9 PM 12:15

SECTION

OTTAWA COUNTY REMONUMENTATION  
LAND CORNER RECORDATION CERTIFICATE  
Filing Requirement of Act 74, Mich. P.A. 1970

*Dan Schiele*  
REGISTER OF DEEDS  
OTTAWA COUNTY, MI

For corners in

Ottawa (County)	Located In:	Corner Code #
1. Public Land Survey	T8N R 14W	L-5 (N $\frac{1}{4}$ , 13) Polkton Twp.
	T R	
	T R	
	T R	
2. Property Controlling in Section	S T R	
	S T R	
3. Miscellaneous Property in Sec.	S T R	
	S T R	

Register of Deeds Stamp & File Number

4. Lot No. \_\_\_\_\_, Recorded Plat \_\_\_\_\_  
5. Private Claims \_\_\_\_\_

1	A	B	C	D	E	F	G	H	I	J	K	L	M
2		6		5		4		3		2		1	
3													
4		7		8		9		10		11		12	
5													
6		18		17		16		15		14		13	
7													
8		19		20		21		22		23		24	
9													
10		30		29		28		27		26		25	
11													
12		31		32		33		34		35		36	
13													

I, Donald W. Schiele, in a field survey on Aug. 24, 1999 do hereby state that under requirements of P.A. 74, Michigan P.A. of 1970, the corner points mentioned in lines 1 and 2 above were in conformance with regulations and rules therefore as required in the current manual of survey instructions of the United States Department of the Interior, Bureau of Land Management or by a decree of a Court of Law and /or that the corner points mentioned in lines 3, 4 and 5 above were in conformance with the rules of the Michigan Board of Land Surveyors or by a Decree of a Court of Law; established, re-established, monumented, recovered, found as expressed below:


NOTE: Not more than 2 corners, all in the same town and range, may be recorded on this certificate.

A. Description of original monument and accessories and/or subsequent restoration:  
 L-5 1/4 corner common to Sections 12 & 13, Polkton Twp.  
 Original Government Corner Record: L.C.R.C. recorded in L.1, P.487, 7-6-72 by  
 Set qr section post C.P. Englert, Jr.:  
 Post 1" Iron Pipe (SEE REVERSE)  
 Sugar 12 S36W 18 N. 20" Maple 43.20  
 Do 8 N47E 10 N.W. 18" Maple 52.40  
 John Mullett, Deputy Surveyor S. 8" Thorneapple 27.13  
 April 8, 1837

B. Description of corner evidence found and/or method applied in restoring or reestablishing corner:  
 L-5 Found Cast Iron Monument inscribed "Section Corner", 6" below surface of gravel road, and accepted as a careful and faithful perpetuation of the position of the original corner.  
 Found reading in SE side of 24" Maple N34°30'E 70.37'(E)  
 Found nail in East side of 18" Locust S03°W 27.21'(E)  
 Centerline 2'± diameter stump N58°W 51.45'(E)

C. Description of monument for corner and accessories established to perpetuate locating the position of the corner:  
 L-5 Cast Iron Monument inscribed "Section Corner", 6" below surface of gravel road.  
 Set Ottawa County Remon Tag & nail in East side of 16" Maple N02°E 59.49'(E)  
 Set Ottawa County Remon Tag & nail in SE side of 24" Maple N34°30'E 70.05'(E)  
 Set Ottawa County Remon Tag & nail in North side of Twin 10" Locust S72°30'E 70.24'(E)  
 Set Ottawa County Remon Tag & nail in East side of 18" Locust S03°W 27.21'(E)  
 Set Ottawa County Remon Tag & nail in South side of 18" Spruce N81°W 178.46'(E)  
 On centerline East & West gravel road.  
 Tree line to North, 1' East.  
 On occupation line ± to South.

Signed by Donald W. Schiele  
Surveyor's Michigan License No. 23517

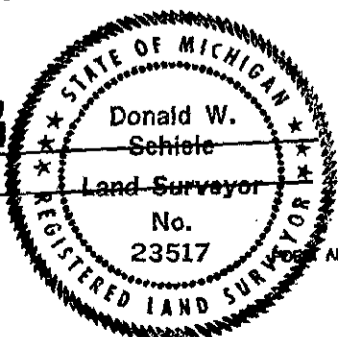

Date August 25, 1999

\$2.00 PHOTO  
Receipt #56820

Part A., continued:

L.C.R.C. recorded in L.4, P.229, 10-22-81 by Thomas E. Joiner:

<u>L-5</u>	Set Cast Iron Monument		
	18" Maple	NW	52.35
	20" Maple	North	43.19
	8" Thornapple	South	26.90
	12" Maple	NE	70.33

FEB 24 2000

SECTION