

SURVEY & REMONUMENTATION

APR 25 1995

COMMISSION

OTTAWA COUNTY REMONUMENTATION
LAND CORNER RECORDATION CERTIFICATE
 Filing Requirement of Act 74, Mich. P.A. 1970

RECORDED

94 DEC -8 PM 12:34

Polkton
 REGISTER OF DEEDS
 OTTAWA COUNTY, MI

For corners in

Ottawa

(County)

Located In:

Corner Code #

- | | | |
|------------------------------------|--------------------------|----------------------------|
| 1. Public Land Survey | T <u>8N</u> R <u>14W</u> | L-7 (N $\frac{1}{4}$, 24) |
| | T _____ R _____ | Polkton Twp. |
| | T _____ R _____ | _____ |
| | T _____ R _____ | _____ |
| 2. Property Controlling in Section | S _____ T _____ R _____ | _____ |
| | S _____ T _____ R _____ | _____ |
| 3. Miscellaneous Property in Sec. | S _____ T _____ R _____ | _____ |
| | S _____ T _____ R _____ | _____ |

Register of Deeds Stamp & File Number

4. Lot No. _____, Recorded Plat _____
 5. Private Claims _____

	A	B	C	D	E	F	G	H	I	J	K	L	M
2	6	5	4	3	2	1							
3													
4	7	8	9	10	11	12							
5													
6	18	17	16	15	14	13							
7													
8	19	20	21	22	23	24							
9													
10	30	29	28	27	26	25							
11													
12	31	32	33	34	35	36							
13													

I, Donald W. Schiele, in a field survey on November 1, 19 94, do hereby certify that under requirements of P.A. 74, Michigan P.A. of 1970, the corner points mentioned in lines 1 and 2 above were in conformance with regulations and rules therefore as required in the current manual of survey instructions of the United States Department of the Interior, Bureau of Land Management or by a decree of a Court of Law and/or that the corner points mentioned in lines 3, 4 and 5 above were in conformance with the rules of the Michigan Board of Land Surveyors or by a Decree of a Court of Law; established, re-established, monumented, re-monumented, recovered, found as expressed below:

NOTE: Not more than 4 corners, all in the same town and range, may be recorded on this certificate.

A. Description of original monument and accessories and/or subsequent restoration:
 L-7 $\frac{1}{4}$ corner common to Sections 13 & 24, Polkton Twp.

Original Government Corner Record: L.C.R.C. recorded in Liber 1, Page 479, 6-23-72
 Set qr section post on true line between Sec. 13 & 24 Solid iron
 Post MBT pole N10°E 56.60'
 Sugar 13 S66E 09 MBT pole S 27.35'
 Do 10 N74W 16 MBT pole S73°W 135.54'
 John Mullett, Deputy Surveyor
 April 8, 1837
 1.5' S of centerline E & W road

L.C.R.C. recorded in Liber 5, Page 357, 12-6-88
 Set CIM
 TP NNE 41.20'
 20" Maple SE 47.50'
 TP SW 26.93'

B. Description of corner evidence found and/or method applied in restoring or reestablishing corner:
 L-7 Found Cast Iron Monument inscribed "Section Corner", 6" below surface in Monument Box, and accepted as a careful and faithful perpetuation of the position of the original corner.

Found nail in East side of Telephone Pole	N12°E	41.09'
Found nail in West side of Telephone Pole	N12°E	41.07'
Found nail in NE side of 20" Maple	S60°E	47.50'
Found PK nail in North side of Telephone Pole	S02°30'W	26.93'
Found PK nail in North side of Telephone Pole	S02°30'W	26.99'
Found nail in NW side of Telephone Pole	S76°W	135.13'

P.A. 345 OTTAWA COUNTY

PEER APPROVED 11/21/94

Donald W. Schiele


C. Description of monument for corner and accessories established to perpetuate locating the position of the corner:

L-7 Cast Iron Monument inscribed "Section Corner", 6" below surface in Monument Box.
 Set Ottawa County Remon Tag & nail in East side of Telephone Pole N12°E 41.12'
 Set Ottawa County Remon Tag & nail in NE side of 20" Maple S60°E 47.49'
 NW corner, footing to House # 410 S38°30'E 107.65'
 Set Ottawa County Remon Tag & nail in East side of 15" Hickory S02°W 38.37'
 NW corner of attached garage, House # 386 S37°30"W 110.60'
 Occupation line North is 3'± East
 Occupation line South is 2'± West
 Centerline asphalt road East & West is 1.5' North

Signed by Donald W. Schiele

Date Nov. 1, 1994

Surveyor's Michigan License No. 23517

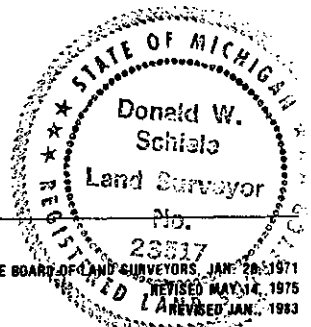

FORM APPROVED BY MICHIGAN STATE BOARD OF LAND SURVEYORS, JAN. 28, 1971
 REVISED MAY 14, 1975
 REVISED JAN., 1983