

APR 05 1996

COMMISSION

OTTAWA COUNTY REMONUMENTATION  
LAND CORNER RECORDATION CERTIFICATE  
Filing Requirement of Act 74, Mich. P.A. 1970

For corners in  
Ottawa (County) Located In: Corner Code #

1. Public Land Survey T8N R14W L-13  
T R S 1/4 cor. Sec.  
T R 36, Polkton Twp.  
T R

2. Property Controlling S T R  
in Section S T R  
3. Miscellaneous S T R  
Property in Sec. S T R

4. Lot No. \_\_\_\_\_, Recorded Plat \_\_\_\_\_  
5. Private Claims \_\_\_\_\_

RECORDED  
95 DEC 12 AM 11:50  
*Robert A. Robinson*  
REGISTER OF DEEDS  
OTTAWA COUNTY, MI  
Register of Deeds Stamp & File Number

I, Steven Lampen, in a field survey on November 15, 1995, do hereby certify that under requirements of P.A. 74, Michigan P.A. of 1970, the corner points mentioned in lines 1 and 2 above were in conformance with regulations and rules therefore as required in the current manual of survey instructions of the United States Department of the Interior, Bureau of Land Management or by a decree of a Court of Law and/or that the corner points mentioned in lines 3, 4 and 5 above were in conformance with the rules of the Michigan Board of Land Surveyors or by a Decree of a Court of Law; established, re-established, monumented, re-monumented, recovered, found as expressed below:


	A	B	C	D	E	F	G	H	I	J	K	L	M
1													
2	6	5	4	3	2	1							
3													
4	7	8	9	10	11	12							
5													
6	18	17	16	15	14	13							
7													
8	19	20	21	22	23	24							
9													
10	30	29	28	27	26	25							
11													
12	31	32	33	34	35	36							
13													

NOTE: Not more than 4 corners, all in the same town and range, may be recorded on this certificate.

- A. Description of original monument and accessories and/or subsequent restoration:  
L-13  
GLO Survey Notes 1837, Surveyor- John Mullett Set post  
12" Beech N 45° E 23 links  
12" Maple N 87° W 23 links  
Survey in L 8-P 192 Found "T" iron  
2nd wood fence post W 30.62'  
6"x8" fence post N 9.82'  
6"x8" fence post E 19.48'  
on fence lines E, W & N
- No LCRC recorded  
Old records of JK & A  
Found "T" iron by Clapp in 1975 at intersection of fences  
30" Ash NNE 111.33'  
NE cor. R.R. tie fence post is W 0.10'
- LCRC L 2-P 689  
Oct. 22, 1974  
Set "T" iron at intersection of fences  
30" Ash NNE 111.33'  
(Recorded as L-1, T4N, R14W)
- B. Description of corner evidence found and/or method applied in restoring or reestablishing corner:  
L-13  
Found "T" iron at intersection of fence lines  
NE cor. of R.R. tie fence post 0.05' W and 0.2' S  
Nail & cap R.L.S. #23520 in E face R.R. tie fence post AZ 0° 00' 9.84'  
Nail & cap R.L.S. #23520 in N face R.R. tie fence post AZ 90° 9.53'
- Replaced "T" iron with standard Ottawa County Remonumentation iron and cap and accepted it as a careful and faithful perpetuation of the position of the original corner.

P.A. 345 OTTAWA COUNTY  
PEER APPROVED 11/20/95  
*Richard D. Newbold*

- C. Description of monument for corner and accessories established to perpetuate locating the position of the corner:  
L-13  
Ottawa County Remonumentation iron and cap  
O.C. Remon. tag & nail E face R.R. tie fence post AZ 0° 9.64'  
O.C. Remon. tag & nail N face R.R. tie fence post AZ 90° 9.33'  
O.C. Remon. tag & nail S face 8" Elm AZ 267° 8.00'  
O.C. Remon. tag & nail E face 6" Hawthorn AZ 20° 14.13'  
N-S fence to North  
On line with E-W fence line

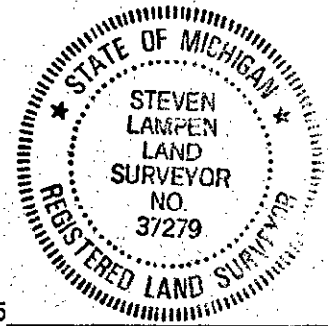

Signed by Steven Lampen Date November 17, 1995  
Surveyor's Michigan License No. 37279