

**SURVEY & REMONUMENTATION**

JUN 28 1999

**OTTAWA COUNTY REMONUMENTATION  
LAND CORNER RECORDATION CERTIFICATE  
Filing Requirement of Act 74, Mich. P.A. 1970**

**RECORDED**

98 NOV 11 PM 1:26

For cornered SECTION  
OTTAWA  
(County)

Located In: Corner Code #

- 1. Public Land Survey T8N R 14W M-1 NE Cor Sec 1  
T R Polkton Twp  
T R  
T R
- 2. Property Controlling in Section S T R
- 3. Miscellaneous Property in Sec. S T R

*Dan Sullivan*  
REGISTER OF DEEDS  
OTTAWA COUNTY, MI

Register of Deeds Stamp & File Number

- 4. Lot No. \_\_\_\_\_, Recorded Plat \_\_\_\_\_
- 5. Private Claims \_\_\_\_\_

I, Randal J. Vugteveen, in a field survey on October 12, 1998 do hereby state that under requirements of P.A. 74, Michigan P.A. of 1970, the corner points mentioned in lines 1 and 2 above were in conformance with regulations and rules therefore as required in the current manual of survey instructions of the United States Department of the Interior, Bureau of Land Management or by a decree of a Court of Law and/or that the corner points mentioned in lines 3, 4 and 5 above were in conformance with the rules of the Michigan Board of Land Surveyors or by a Decree of a Court of Law, established, re-established, monumented, recovered, found as expressed below.

NOTE: Not more than 2 corners, all in the same town and range, may be recorded on this certificate.

	A	B	C	D	E	F	G	H	I	J	K	L	M
1													
2	6		5		4		3		2		1		
3													
4	7		8		9		10		11		12		
5													
6	18		17		16		15		14		13		
7													
8	19		20		21		22		23		24		
9													
10	30		29		28		27		26		25		
11													
12	31		32		33		34		35		36		
13													

**A. Description of original monument and accessories and/or subsequent restoration:**

M-1 set by Mullet April 7, 1837

Set township corner for Town 8 & 9 N, Range 13 & 14 W

20" sugar S63W 17 links

8" beech S43E 30 links

M-1 T8N, R14W Liber 2, Page 743

Englert Feb. 1975

Found 4" brass marker

SW 28" maple 87.00'

SE USGS B.M 40.49'

NW st. sign 38.70'

A-13 T9N, R13W Liber 6, Page 119

Joiner Oct. 1990

Found brass plug in conc.

P.K. in Tel. Pole SE 55.33'

20" maple SW 133.87'

Street sign NW 57.38'

PP NE 116.56'

**B. Description of corner evidence found and/or method applied in restoring or reestablishing corner:**

M-1 found brass marker in concrete in monument box

- Found nail NW side power pole N40°E 116.58'
- Found P.K. nail in SW side tel pole S48°E 55.63'
- Found nail in E. side 24" maple S11°W 113.81'

set "X" cut in existing brass marker in concrete in monument box


Accepted Brass Marker in concrete as a careful and faithful perpetuation of the position of the original corner

**C. Description of monument for corner and accessories established to perpetuate locating the position of the corner:**

M-1 Brass Marker in concrete in Monument Box

- Ottawa County Remon tag and Nail NW side power pole N40°E 116.58'
- Ottawa County remon tag and Nail SW side telephone pole S48°E 55.63'
- Ottawa County remon tag and Nail NW side cut power pole/fence post S45°W 54.64'
- Ottawa County remon tag and Nail E. side 24" maple S11°W 133.81'
- CL "X" 2.8' south

PA. 345 OTTAWA COUNTY  
PEER APPROVED 10/19/98

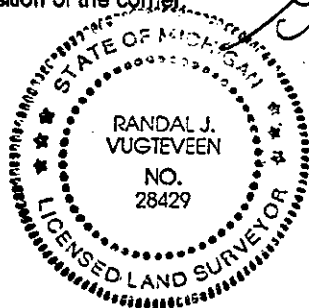

\$9.00 CORNER  
Receipt #19293

Signed by *Randal J. Vugteveen*  
Surveyor's Michigan License No. 28429

Date Oct 19, 1998

\$1.00 PHOTO  
Receipt #19293

LIBER 004 PAGE 268