

DEC 01 1998

OTTAWA COUNTY REMONUMENTATION LAND CORNER RECORDATION CERTIFICATE Filing Requirement of Act 74, Mich. P.A. 1970

RECORDED

98 JUL 21 PM 12:14

SECTION

Handwritten signature and REGISTER OF DEEDS OTTAWA COUNTY, MI

Four corners in

Table with columns: Ottawa (County), Located In, Corner Code #. Includes entries for Public Land Survey, Property Controlling in Section, and Miscellaneous Property in Sec.

Register of Deeds Stamp & File Number

4. Lot No. Recorded Plat
5. Private Claims

Grid table with columns A-M and rows 1-13. A dot is marked at the intersection of column M and row 1.

I, Donald W. Schiele, in a field survey on June 10, 1998 do hereby state that under requirements of P.A. 74, Michigan P.A. of 1970, the corner points mentioned in lines 1 and 2 above were in conformance with regulations and rules therefore as required in the current manual of survey instructions of the United States Department of the Interior, Bureau of Land Management or by a decree of a Court of Law and for that the corner points mentioned in lines 3, 4 and 5 above were in conformance with the rules of the Michigan Board of Land Surveyors or by a Decree of a Court of Law; established, re-established, monumented, recovered, found as expressed below:

NOTE: Not more than 2 corners, all in the same town and range, may be recorded on this certificate.

A. Description of original monument and accessories and/or subsequent restoration:

M-2 1/4 corner common to Sec. 1, Polkton Twp. and Sec. 6, T8N, R13W, Wright Twp. Original Government Corner Record: Set qr sec Post from which a Lynn 24 in dia bears S35E 19 lks dist & a do 36 " " " N45W 11 " " Post John Mullett, Deputy Surveyor April 7, 1837 From Ottawa County Surveyor records (undated): A-2, T8N, R13W: 1. Found stone. West 29.5, S. 2ft. to fence post 2. Found Stone & Iron bar. 3. Placed 3" Tile over rod in 9" Conc. Rd. P.A. 848 OTTAWA COUNTY (SEE REVERSE) PEER APPROVED 6-15-98

Handwritten signature M.O.N.

B. Description of corner evidence found and/or method applied in restoring or reestablishing corner:


M-2 Found PK nail & tag in asphalt road surface. Found Steel Bar with Ottawa County Remon Cap in Monument Box: SE cor., Sec. 1, T8N, R14W South 2662.86' Found nail & tag in East side of 24" Maple trunk S27°30'W 58.78'(E) Found 6" stub of a 1 1/2" square wood stake, 2' below asphalt road surface in rock pile, and 0.23' North, 0.09' East of found PK nail & tag. Accepted wood stake stub as a careful and faithful perpetuation of the position of the original corner.

C. Description of monument for corner and accessories established to perpetuate locating the position of the corner:

M-2 Removed 1 1/2" square wood stake stub and replaced with 3/4" X 24" Steel Bar with Ottawa County Remon Cap, 3" below asphalt road surface in Monument Box. Set Ottawa County Remon Tag & nail in West side of 6" Cherry N05°E 364.53'(E) Set Ottawa County Remon Tag & nail in SE side of 4" Maple S13°E 133.35'(E) Set Ottawa County Remon Tag & nail in NW side of 24" Maple trunk S27°30'W 59.04'(E) Chiselled "X" in West end of concrete headwall N05°30'W 198.47'(E) Centerline asphalt road North & South, 0.3' East (SEE SKETCH ON REVERSE)

Signed by Donald W. Schiele Surveyor's Michigan License No. 23517

Date 6-15-1998

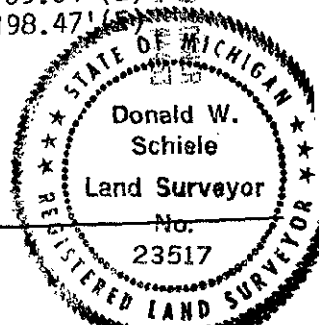

SURVEY &
REMONUMENTATION

DEC 01 1998

SECTION

Part A., continued:

L.C.R.C. recorded in L. 2, P. 743, 2-20-75:

M-2

(Found) Iron Bar in 4" Tile

S.W. 59.00 24" Maple

N.E. 16" Maple 49.85

E. To E. Edge of pavement 5.25

From Tru-Line Surveying survey for Lemmen Realty, 3-29-90, by Maurice J. Rosema, as recorded in L. 7, Certified Survey Maps of Ottawa County, P. 280:

A-2, T8N, R13W

Record distance to SW corner, Section 6 = 2662.96'

From field notes attendant to above survey:

W 1/4 cor, Sec. 6, T8N, R13W

Set PK Nail & Tag

Set Nail & Tag in E. side 25" Maple -- SSW 58.82'

