

OTTAWA COUNTY REMONUMENTATION  
 LAND CORNER RECORDATION CERTIFICATE  
 Filing Requirement of Act 74, Mich. P.A. 1970

RECORDED

96 DEC 18 PM 4: 55

For corners in

<u>Ottawa</u> (County)	Located in:	Corner Code #
1. Public Land Survey	T <u>8N</u> R <u>14W</u>	<u>M-4 (E 1/4, 12)</u> <u>Polkton Twp.</u>
	T _____ R _____	_____
	T _____ R _____	_____
	T _____ R _____	_____
2. Property Controlling in Section	S _____ T _____ R _____	_____
	S _____ T _____ R _____	_____
3. Miscellaneous Property in Sec.	S _____ T _____ R _____	_____
	S _____ T _____ R _____	_____
4. Lot No. _____, Recorded Plat _____		
5. Private Claims _____		

*Register of Deeds*  
 REGISTER OF DEEDS  
 OTTAWA COUNTY, MI

Register of Deeds Stamp & File Number

I, Donald W. Schiele, in a field survey on December 6, 1996  
do hereby certify that under requirements of P.A. 74, Michigan P.A. of 1970, the corner points mentioned  
in lines 1 and 2 above were in conformance with regulations and rules therefore as required in the  
current manual of survey instructions of the United States Department of the Interior, Bureau of Land  
Management or by a decree of a Court of Law and/or that the corner points mentioned in lines 3, 4 and 5  
above were in conformance with the rules of the Michigan Board of Land Surveyors or by a Decree of a  
Court of Law; established, re-established, monumented, re-monumented, recovered, found as  
expressed below:

A	B	C	D	E	F	G	H	I	J	K	L	M
2	6	5	4	3	2	1						
3												
4	7	8	9	10	11	12						
5												
6	18	17	16	15	14	13						
7												
8	19	20	21	22	23	24						
9												
10	30	29	28	27	26	25						
11												
12	31	32	33	34	35	36						
13												

**NOTE: Not more than 4 corners, all in the same town and range, may be recorded on this certificate.**

A. Description of original monument and accessories and/or subsequent restoration:

M-4 1/4 corner common to Section 12, Polkton Twp. and Section 7, Wright Twp.

Original Government Corner Record:

Set qr sec post from which

a Beech 9 in dia bears S11W 32 lks dist

& an Ironwood 6 " " " N6W 11 " "

Post

John Mullett, Deputy Surveyor

April 7, 1837

(SEE REVERSE)

B. Description of corner evidence found and/or method applied in restoring or reestablishing corner:

M-4 Found 5/8" x 18" Steel Bar 14" below road surface, cemented in 3" Clay Tile cemented in 8" thick concrete road under Railroad Spike in 4" asphalt surface, and accepted Steel Bar as a careful and faithful perpetuation of the position of the original corner.

Railroad Spike was 0.15' North and 0.06' West of Steel Bar.

Found spike in SW side of 3" Triple Thornapple N48°E 56.71'(E)


Found spike in South side of Power Pole S87°30'E 27.99'(E)

Found spike in NE side of 8" Elm S64°E 39.57'(E)

PA. 345 OTTAWA COUNTY

PEER APPROVED 12-9-96

*D.W.S.*

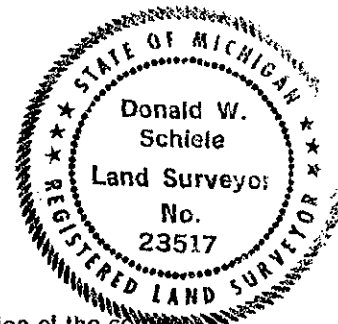

C. Description of monument for corner and accessories established to perpetuate locating the position of the corner:

M-4 Removed 5/8" x 18" Steel Bar and Railroad Spike, and replaced Steel Bar with 3/4" x 24" Steel Bar with Ottawa County Remon Cap, 3" below asphalt surface in Monument Box.

Set Ottawa County Remon Tag & nail in NW side of 4" Quad Apple N47°E 57.91'(E)

Set Ottawa County Remon Tag & nail in North side of Power Pole S87°30'E 28.00'(E)

Set Ottawa County Remon Tag & nail in SW side of 8" Elm S64°E 39.49'(E)

Set Ottawa County Remon Tag & nail in North side of Power Pole S90°W 155.10'(E)

Centerline asphalt road North & South, 0.4' East

On centerline fence line East

On centerline occupation line West

(SEE SKETCH ON REVERSE)

Signed by Donald W. Schiele

Date December 8, 1996

Surveyor's Michigan License No. 23517

Part A., continued:

From Ottawa County Surveyor records:

(no date): Found Stone: W. 33 to Fence Post

(no date): Found Stone W. 29.5 S. 2' to F. Post

(no date): Iron & Stone NW 43.0 Conc. F. Post  
SW 47.7 C/L 16" Cherry

Approx. 1920: Found Stone & Iron Rod. Placed 3" Tile over Rod in 9' Conc. Rd.

Field notes, 9-22-86, Carl P. Englert: Clay Tile in Conc. Rd.

L. 8 Certified Survey Maps of Ottawa County, P. 647, 4-18-96, Maurice Rosema:

W. 1/4 cor. Sec. 7, T8N, R13W

RR Spk.

Mag nail in S side P.P. E 28.07'

Spk in N side 6" Cherry SE 39.57'

Spk in S side 4" Thornapple Clump NE 56.93'

C/L base of Tele. Box W 34.94'

