

SURVEY & REMONUMENTATION

FEB 27 1998

**OTTAWA COUNTY REMONUMENTATION
LAND CORNER RECORDATION CERTIFICATE
Filing Requirement of Act 74, Mich. P.A. 1970**

SECTION

For corners in

<u>Ottawa</u> (County)	Located In:	Corner Code #
1. Public Land Survey	T <u>8N</u> R <u>14W</u>	<u>M-5 (SE, 12)</u> <u>Polkton Twp.</u> <u>Common corner</u> <u>to A-5, Wright</u> <u>Twp.</u>
2. Property Controlling in Section	S ___ T ___ R ___	___
3. Miscellaneous Property in Sec.	S ___ T ___ R ___	___

RECORDED
97DEC-8 AM 11:33

Harry Mullett
REGISTER OF DEEDS
OTTAWA COUNTY, MI

Register of Deeds Stamp & File Number

4. Lot No. _____, Recorded Plat _____
5. Private Claims _____

	A	B	C	D	E	F	G	H	I	J	K	L
2	6		5		4		3		2		1	
3												
4	7		8		9		10		11		12	
5												
6	18		17		16		15		14		13	
7												
8	19		20		21		22		23		24	
9												
10	30		29		28		27		26		25	
11												
12	31		32		33		34		35		36	
13												

I, Donald W. Schiele, in a field survey on November 29, 19 97, do hereby certify that under requirements of P.A. 74, Michigan P.A. of 1970, the corner points mentioned in lines 1 and 2 above were in conformance with regulations and rules therefore as required in the current manual of survey instructions of the United States Department of the Interior, Bureau of Land Management or by a decree of a Court of Law and/or that the corner points mentioned in lines 3, 4 and 5 above were in conformance with the rules of the Michigan Board of Land Surveyors or by a Decree of a Court of Law; established, re-established, monumented, re-monumented, recovered, found as expressed below:

NOTE: Not more than 4 corners, all in the same town and range, may be recorded on this certificate.

A. Description of original monument and accessories and/or subsequent restoration:

M-5 Corner common to Sections 12 & 13, Polkton Twp. and Sections 7 & 18, Wright Twp., T8N, R13 W

Original Government Corner Record: L.C.R.C. recorded in Liber 3, Page 387, 9-5-79; (SEE REVERSE)
Set post cor secs. 12 & 13 from which a Beech 13 in dia bears S40W 10 lks dist & a Do 9 " " " N22W 32 " " 3/4" iron.
Post Nail in sde 24" Maple WSW 54.11'
John Mullett, Deputy Surveyor Nail in sde 40" Oak SE 44.05'
April 7, 1837 C/L St. sign NW 42.7'
C/L 9' concrete road West 4.8'

B. Description of corner evidence found and/or method applied in restoring or reestablishing corner:

M-5 Found 3/4" Steel Bar, 6" below surface of asphalt road. 60" Oak S48°30'E 43.81'; 28" Maple S65°W 53.82'; Stone, 24" deep in C/L asphalt road West 5.00'.
Rejected 3/4" Steel Bar as M-5, as recorded in Liber 3, Page 387, 9-5-79. This position was originally established as a witness to the section corner.
Accepted Stone, 24" deep in centerline North & South asphalt road, as a careful and faithful perpetuation of the position of the original corner.
Found 3/4" Steel Bar N90°E 5.00'
Found nail & washer in SW side of 60" Oak S52°30'E 47.49'
Found nail & washer in NW side of 28" Maple S62°30'W 49.28'


P.A. 345 OTTAWA COUNTY

PEER APPROVED *12-1-97*
[Signature]

C. Description of monument for corner and accessories established to perpetuate locating the position of the corner:

M-5 Set 3/4" X 21" Steel Bar with Ottawa County Remon Cap over Stone, 2" below surface of asphalt road in Monument Box.
3/4" Steel Bar N90°E 5.00'
Set Ottawa County Remon Tag & nail in SW side of 60" Oak S52°30'E 47.77'
Set Ottawa County Remon Tag & nail in NW side of 28" Maple S62°30'W 49.29'
Set Ottawa County Remon Tag & nail in SW side of 8" Ash N71°30'W 83.98'
Set Ottawa County Remon Tag & nail in East side of Power Pole N15°W 124.74'
On centerline asphalt road North & South
On centerline private drive to East
Centerline gravel road to West, 2' North (SEE SKETCH ON REVERSE)

Signed by Donald W. Schiele Date Dec. 1, 1997
Surveyor's Michigan License No. 23517

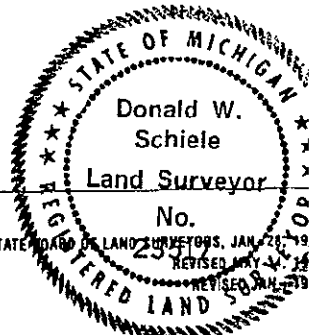

FORM APPROVED BY MICHIGAN STATE BOARD OF LAND SURVEYORS, JAN. 28, 1997, REVISED MAY 14, 1998

\$ 2.00 PHOTO

Part A., continued:

Ottawa County Surveyor Records (no date):
(M-5) Stake Pine Stump 36 N89½ 3.28½

Ottawa County Surveyor Records (no date):
(M-5) Stake & Stone 12" Maple S63¾W 48.7
6" Oak S50E 47.7

Ottawa County Surveyor Records (no date):
(M-5) Cement F Post N43°W 43ft.
Found stone. Planted iron bar.

Ottawa County Surveyor Records (no date):
(M-5) Set Gas Pipe 5ft E of Sec. Cor. on E. side of Concrete Road

Ottawa County Surveyor Records, 1972:
(M-5) Iron SE 44.05 to PK in 34" Oak
SW 51.40 to PK in 18" Maple
5' E of C/L Pavement

SURVEY & REMONUMENTATION

FEB 27 1998

SECTION

