

APR 05 1996

COMMISSION

OTTAWA COUNTY REMONUMENTATION
LAND CORNER RECORDATION CERTIFICATE

Filing Requirement of Act 74, Mich. P.A. 1970

For corners in
Ottawa _____ Located In: _____ Corner Code # _____
(County)

1. Public Land Survey T8N R14W M-6
T _____ R _____
T _____ R _____
T _____ R _____

2. Property Controlling S _____ T _____
in Section S _____ T _____
3. Miscellaneous S _____ T _____
Property in Sec. S _____ T _____

RECORDED
95 NOV 29 PM 1:41
Richard Holzman
REGISTER OF DEEDS
OTTAWA COUNTY, MI
Register of Deeds Stamp & File Number

4. Lot No. _____, Recorded Plat _____
5. Private Claims _____

I, Steven Lampen _____, in a field survey on November 15 1995, do hereby certify that under requirements of P.A. 74, Michigan P.A. of 1970, the corner points mentioned in lines 1 and 2 above were in conformance with regulations and rules therefore as required in the current manual of survey instructions of the United States Department of the Interior, Bureau of Land Management or by a decree of a Court of Law and/or that the corner points mentioned in lines 3, 4 and 5 above were in conformance with the rules of the Michigan Board of Land Surveyors or by a Decree of a Court of Law, established, re-established, monumented, re-monumented, recovered, found as expressed below:

NOTE: Not more than 4 corners, all in the same town and range, may be recorded on this certificate.

A. Description of original monument and accessories and/or subsequent restoration:

| | | |
|--|---|---|
| M-6 GLO Survey Notes 1837, Surveyor - John Mullett 9" Maple S 58° W 37 links 13" Maple N 7° W 36 links | LCRC L 3-P 387 Sept. 5, 1979 Set P.K. nail from ties Nail in side 6" Apple E 38.30' Nail in side power pole SW 45.45' Nail in side 15" Maple SE 98.25' On centerline 9' wide concrete road Fence and tree line E & W | LCRC L 6-P 28 Jan. 3, 1990 Found P.K. set cast iron monument- 6" Apple E 38.28' 15" Maple SE 98.25' Power pole SW 45.47' |
|--|---|---|

B. Description of corner evidence found and/or method applied in restoring or reestablishing corner:

M-6
Found cast iron monument and accepted it as a careful and faithful perpetuation of the position of the original corner.


Found nail & washer in N side 14" Apple S 83° E 38.28'
6" Apple E 38.28'
15" Maple SE 98.25'
Power pole SW 45.47'

P.A. 345 OTTAWA COUNTY
PEER APPROVED 11/20/95

Richard D. McDowell
RDM

C. Description of monument for corner and accessories established to perpetuate locating the position of the corner:

M-6
Cast iron monument
Set O. C. Remonumentation tag & nail in S side 14" Apple S 83° E 38.34'
Set O. C. Remon. tag & nail in W side 16" Maple S 15° E 97.73'
Set O. C. Remon. tag & nail in SE side power pole S 64° W 45.49'
Set O. C. Remon. tag & nail side power pole N 38° E 182.37'

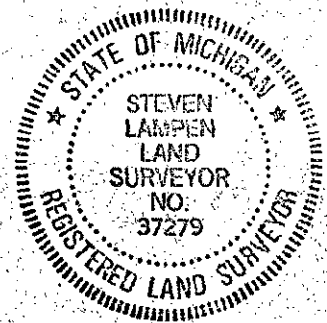

Signed by Steven Lampen
Surveyor's Michigan License No. 37279

Date November 17, 1995