

**SURVEY & REMONUMENTATION**

APR 25 1995

**OTTAWA COUNTY REMONUMENTATION  
LAND CORNER RECORDATION CERTIFICATE  
Filing Requirement of Act 74, Mich. P.A. 1970**

RECORDED

94 DEC -8 PM 12: 31

**COMMISSION**

corners in

Ottawa

(County)

Located In:

Corner Code #

Public Land Survey

T 8N R 14W

M-7 (NE, 24)

Polkton Twp.

Property Controlling in Section

S T R

Miscellaneous

S T R

Property in Sec.

S T R

*Dorothy C. Henderson*  
REGISTER OF DEEDS  
OTTAWA COUNTY, MI

Register of Deeds Stamp & File Number

Lot No. \_\_\_\_\_, Recorded Plat \_\_\_\_\_

Private Claims \_\_\_\_\_

	A	B	C	D	E	F	G	H	I	J	K	L	M
2	6	5	4	3	2	1							
3													
4	7	8	9	10	11	12							
5													
6	18	17	16	15	14	13							
7													
8	19	20	21	22	23	24							
9													
10	30	29	28	27	26	25							
11													
12	31	32	33	34	35	36							
13													

Donald W. Schiele, in a field survey on November 15, 1994

hereby certify that under requirements of P.A. 74, Michigan P.A. of 1970, the corner points mentioned in lines 1 and 2 above were in conformance with regulations and rules therefore as required in the current manual of survey instructions of the United States Department of the Interior, Bureau of Land Management or by a decree of a Court of Law and/or that the corner points mentioned in lines 3, 4 and 5 above were in conformance with the rules of the Michigan Board of Land Surveyors or by a Decree of a Court of Law; established, re-established, monumented, re-monumented, recovered, found as expressed below:

**NOTE: Not more than 4 corners, all in the same town and range, may be recorded on this certificate.**

Description of original monument and accessories and/or subsequent restoration:

-7 NE corner of Section 24 & SE corner of Section 13, Polkton Twp.  
Original Government L.C.R.C. recorded in Liber 1, L.C.R.C. recorded in Liber 5,  
Corner Record: Page 477, 6-23-72 Page 357, 12-6-88  
Set corner post Sec. 13 & 24 3/4" Iron Set CIM  
Post CP pole S40°W 88.90' LP NE 31.45'  
Cymn 16 S29W 11 lks MBT pole N43°E 31.39' 10" Tri. Birch NW 45.00'  
Cymn 9 N26½W 20 " St sign S58°E 53.84' PP SW 83.75'  
John Mullett, Deputy Surveyor 17.6' N of centerline pavt  
April 7, 1837

Description of corner evidence found and/or method applied in restoring or reestablishing corner:

-7 Found Cast Iron Monument inscribed "Section Corner", at pavement surface in Monument Box, and accepted as a careful and faithful perpetuation of the position of the original corner.  
Found nail in NW side of Light Pole N52°30'E 31.51'  
Found PK nail in NW side of Light Pole N52°30'E 31.47'  
Found nail in SE side of Power Pole S38°W 88.81'  
Found nail in NW side of Power Pole S38°W 88.70'  
Centerline asphalt road East & West, 17.6' South


P.A. 345 OTTAWA COUNTY

PEER APPROVED 11/21/94

*Maday D. Medwell*

Description of monument for corner and accessories established to perpetuate locating the position of the corner:

-7 Cast Iron Monument inscribed "Section Corner", at pavement surface in Monument Box.  
Set Ottawa County Remon Tag & nail in SE side of Light Pole N52°30'E 31.44'  
Set Ottawa County Remon Tag & nail in North side of 7" Pine S69°E 165.10'  
Set Ottawa County Remon Tag & nail in SE side of Power Pole S38°W 88.79'  
SE corner, brick face to attached garage to House # 781 N49°30'W 94.52'  
On centerlines asphalt road to North & gravel road to South  
Centerline asphalt road East & West, 17.6' South

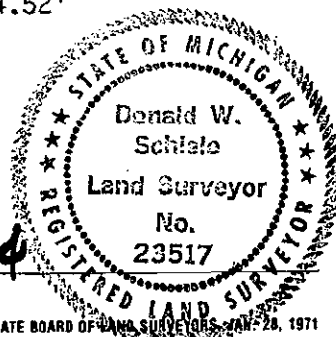

Signed by Donald W. Schiele

Date Nov. 21, 1994

Surveyor's Michigan License No. 23517