

**SURVEY &  
REMONUMENTATION**

**OTTAWA COUNTY REMONUMENTATION**

**APR 05 1996**

**LAND CORNER RECORDATION CERTIFICATE**

**Filing Requirement of Act 74, Mich. P.A. 1970**

**COMMISSION**

For corners in  
Ottawa  
(County)

Located In:

Corner Code #

- |                                    |     |      |                  |
|------------------------------------|-----|------|------------------|
| 1. Public Land Survey              | T8N | R14W | M-10             |
|                                    | T   | R    | E 1/4 cor. Sec.  |
|                                    | T   | R    | 25, Polkton Twp. |
|                                    | T   | R    |                  |
| 2. Property Controlling in Section | S   | T    | R                |
|                                    | S   | T    | R                |
| 3. Miscellaneous Property in Sec.  | S   | T    | R                |
|                                    | S   | T    | R                |

**RECORDED**

95 DEC 12 AM 11:51

*Richard Williams*  
REGISTER OF DEEDS  
OTTAWA COUNTY, MI

Register of Deeds Stamp & File Number

4. Lot No. \_\_\_\_\_, Recorded Plat \_\_\_\_\_  
5. Private Claims \_\_\_\_\_

	A	B	C	D	E	F	G	H	I	J	K	L	M
1													
2	6	5	4	3	2	1							
3													
4	7	8	9	10	11	12							
5													
6	18	17	16	15	14	13							
7													
8	19	20	21	22	23	24							
9													
10	30	29	28	27	26	25							
11													
12	31	32	33	34	35	36							
13													

I, Steven Lampen, in a field survey on November 15, 1995, do hereby certify that under requirements of P.A. 74, Michigan P.A. of 1970, the corner points mentioned in lines 1 and 2 above were in conformance with regulations and rules therefore as required in the current manual of survey instructions of the United States Department of the Interior, Bureau of Land Management or by a decree of a Court of Law and/or that the corner points mentioned in lines 3, 4 and 5 above were in conformance with the rules of the Michigan Board of Land Surveyors or by a Decree of a Court of Law; established, re-established, monumented, re-monumented, recovered, found as expressed below:

**NOTE: Not more than 4 corners, all in the same town and range, may be recorded on this certificate.**

- A. Description of original monument and accessories and/or subsequent restoration:  
M-10  
GLO Survey Notes 1837, Surveyor - John Mullett Set post  
6" Ironwood S 57° W 15 links  
9" Elm N 25° W 29 links  
No LCRC recorded  
L 7 Certified Surveys P 243 shows cast iron monument  
Guard rail post SE 23.24'  
"X" in concrete bridge rail NE 18.46'  
"X" in concrete bridge rail NW 18.68'  
Guard rail post SW 23.27'


See page two

- B. Description of corner evidence found and/or method applied in restoring or reestablishing corner:  
M-10  
Found cast iron monument from previous ties and accepted it as a careful and faithful perpetuation of the position of the original corner.

Guard rail post SE 23.24'  
"X" in concrete bridge rail NE 18.46'  
"X" in concrete bridge rail NW 18.68'  
Guard rail post SW 23.27'

P.A. 345 OTTAWA COUNTY  
PEER APPROVED 11/20/95  
*Richard Williams*

- C. Description of monument for corner and accessories established to perpetuate locating the position of the corner:  
M-10  
Cast iron monument  
Set O. C. Remonumentation tag & nail in top of guard rail post S 46° W 23.39'  
Set O. C. Remon. tag & nail in top of guard rail post S 39° E 23.29'  
Cut "X" in concrete bridge rail N 55° E 20.20'  
Cut "X" in concrete bridge rail N 45° W 18.68'

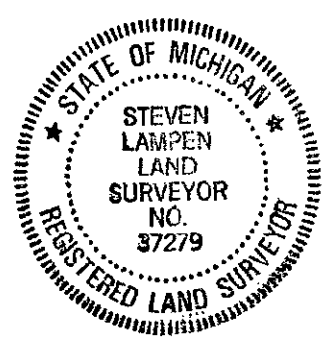

Signed by Steven Lampen  
Surveyor's Michigan License No. 37279

Date November 17, 1995

A. Cont'd

K-13 (Recorded as K-1, T7N, R14W)

LCRC L 2-P 61

August 6, 1973

5/8" rod in fence corner

9" Maple N 2.90'

13" Maple NW 14.35'

10" Maple S 5.00'

K-13 (Recorded as K-1, T7N, R14W)

LCRC L 4-P 48

April 14, 1980

Found iron, set cast iron mon.

9" Maple N 2.90'

13" Maple NW 14.45'

14" Maple ENE 24.18'

14" Maple SE 24.75'

4 11.00 CORNER