

FEB 24 2000

RECORDED

OTTAWA COUNTY REMONUMENTATION 99 DEC -2 PH 1:13

LAND CORNER RECORDATION CERTIFICATE
Filing Requirement of Act 74, Mich. P.A. 1970

Randy Libelta
REGISTER OF DEEDS
OTTAWA COUNTY, MI

SECTION

For corners in

OTTAWA

(County)

Located In:

Corner Code #

1. Public Land Survey

T 8N R 14W A-3 NW corner
Section 7, Polkton
Twp

2. Property Controlling in Section

S T R

3. Miscellaneous Property in Sec.

S T R

Seg. 2

Register of Deeds Stamp & File Number

4. Lot No. _____, Recorded Plat _____
5. Private Claims _____

A	B	C	D	E	F	G	H	I	J	K	L	M
1												
2	6	5	4	3	2	1						
3												
4	7	8	9	10	11	12						
5												
6	18	17	16	15	14	13						
7												
8	19	20	21	22	23	24						
9												
10	30	29	28	27	26	25						
11												
12	31	32	33	34	35	36						
13												

I, Randal J. Vugteveen, in a field survey on October 16, 1999 do hereby state that under requirements of P.A. 74, Michigan P.A. of 1970, the corner points mentioned in lines 1 and 2 above were in conformance with regulations and rules therefore as required in the current manual of survey instructions of the United States Department of the Interior, Bureau of Land Management or by a decree of a Court of Law and /or that the corner points mentioned in lines 3, 4 and 5 above were in conformance with the rules of the Michigan Board of Land Surveyors or by a Decree of a Court of Law, established, re-established, monumented, recovered, found as expressed below:

NOTE: Not more than 2 corners, all in the same town and range, may be recorded on this certificate.

A. Description of original monument and accessories and/or subsequent restoration:

A-3 Liber 2, Page 478 Remonumentation approved October 1995 (Englert)

Corner Common to Sections 6 & 7, T8N, R14W &

Sections 1 & 12, T8N, R15W

4" CIM

Nail & Remon Tag in W side 26" Spruce N39°E

53.03'

Nail & Remon Tag in E side P. Pole S15°W 119.95'

Nail & Remon Tag in E side P. Pole N10°W 185.52'

Nail & Remon Tag in S side P. Pole N78°E 246.08'

B. Description of corner evidence found and/or method applied in restoring or reestablishing corner:

A-3 Found 3/4" X 36" steel bar with Ottawa County Remon Cap in Gravel Road

Found Nail & Remon Tag in W side 26" Spruce N40°E 53.01'

Found Nail & Remon Tag in E side P. Pole N10°W 185.44'

Found Nail & Remon Tag in E side P. Pole S15°W 119.93'

Accepted Bar with Remon Cap as a careful and faithful perpetuation of the position of the original corner.

11/15/99
YDN

C. Description of monument for corner and accessories established to perpetuate locating the position of the corner:

A-3 3/4" X 36" Iron Bar with O.C. Remon Cap

Corner common to M-3 Crockery Twp


Found Nail & Remon Tag in W side 28" Spruce N40°E 53.01'

Found Nail & Remon Tag in E side Power Pole N10°W 185.44'

Found Nail & Remon Tag in E side Power Pole S15°W 119.93'

Capped iron bar witness S45°W 68.80'

On centerline "X" gravel road (to be paved October 21, 1999)

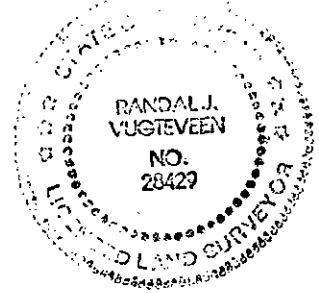

\$11.00 CORNER
Receipt #64945

Signed by *Randal J. Vugteveen*
Surveyor's Michigan License No. 28429

Date OCTOBER 27, 1999