

RECORDED

94 DEC -8 PM 12: 35

OTTAWA COUNTY REMONUMENTATION  
LAND CORNER RECORDATION CERTIFICATE  
Filing Requirement of Act 74, Mich. P.A. 1970

*Richard R. Robinson*  
REGISTER OF DEEDS  
OTTAWA COUNTY, MI


or corners in

<u>Ottawa</u> (County)	Located In:	Corner Code #/
Public Land Survey	T <u>8N</u> R <u>14W</u>	<u>E-9 (NW, 28)</u>
	T _____ R _____	<u>Polkton Twp.</u>
	T _____ R _____	_____
	T _____ R _____	_____
Property Controlling in Section	S _____ T _____ R _____	<u>Seg. #2 pm</u>
Miscellaneous	S _____ T _____ R _____	_____
Property in Sec.	S _____ T _____ R _____	_____

Register of Deeds Stamp & File Number

Lot No. \_\_\_\_\_, Recorded Plat \_\_\_\_\_  
Private Claims \_\_\_\_\_

Donald W. Schiele, in a field survey on November 19, 19 94  
I hereby certify that under requirements of P.A. 74, Michigan P.A. of 1970, the corner points mentioned in lines 1 and 2 above were in conformance with regulations and rules therefore as required in the current manual of survey instructions of the United States Department of the Interior, Bureau of Land Management or by a decree of a Court of Law and/or that the corner points mentioned in lines 3, 4 and 5 above were in conformance with the rules of the Michigan Board of Land Surveyors or by a Decree of a Court of Law; established, re-established, monumented, re-monumented, recovered, found as pressed below:

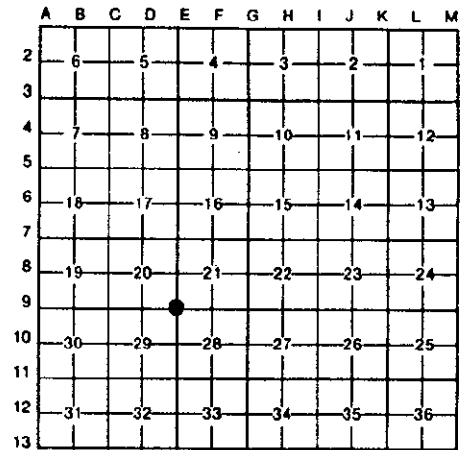

**NOTE: Not more than 4 corners, all in the same town and range, may be recorded on this certificate.**

Description of original monument and accessories and/or subsequent restoration:  
-9 corner common to Sections 20, 21, 28 & 29, Polkton Twp.  
T.C.R.C. recorded in Remon Liber 1, Page 190, 12-15-93  
Cast Iron Monument with top broken off 6" below surface.  
W corner, foundation to House # 7961  
at Ottawa County Remon Tag & nail in South side of Power Pole  
at Ottawa County Remon Tag & nail in NE side of Fence Post  
at Ottawa County Remon Tag & nail in SE side of Power Pole  
at Ottawa County Remon Tag & nail in East side of Power Pole  
centerline gravel road to North, 1' East  
centerline gravel road East & West

N70°E	273.33'(E)
S78°E	180.19'(E)
S38°E	26.69'
S51°W	83.10'
N12°W	290.80'(E)

Description of corner evidence found and/or method applied in restoring or reestablishing corner:

-9 Found Cast Iron Monument (broken), 17" below surface.  
W corner, foundation to House # 7961  
ound Ottawa County Remon Tag & nail in South side of Power Pole  
ound Ottawa County Remon Tag & nail in SE side of Power Pole  
ound Ottawa County Remon Tag & nail in East side of Power Pole  
at 3/4" X 14" steel bar with Ottawa County Remon Cap in concrete over broken Cast Iron monument, adjusted to best fit original witnesses, and accepted as a careful and faithful perpetuation of the position of the original corner.  
ote: This corner was raised to prepare for asphalt paving.

N70°E	273.47'(C)
S78°E	180.32'(E)
S51°W	83.04'
N12°W	290.82'(E)


P.A. 345 OTTAWA COUNTY

PEER APPROVED 11/21/94

Description of monument for corner and accessories established to perpetuate location of the corner:  
-9 3/4" X 14" steel bar with Ottawa County Remon Cap over Cast Iron Monument (broken), 4 1/2" below surface in Monument Box.

W corner, foundation to House # 7961	N70°E	273.38'(E)
ttawa County Remon Tag & nail in South side of Power Pole	S78°E	180.23'(E)
ttawa County Remon Tag & nail in SE side of Power Pole	S51°W	83.12'
ttawa County Remon Tag & nail in East side of Power Pole	N12°W	290.85'(E)

centerline gravel road to North, 1' East  
centerline asphalt road East & West, 0.5' North

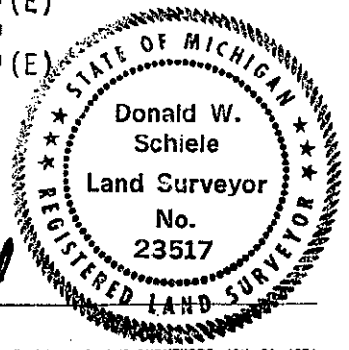

Signed by Donald W. Schiele

Date Nov. 21, 1994

Surveyor's Michigan License No. 23517