

SURVEY &
REMONUMENTATION

DEC 16 1996

COMMISSION

OTTAWA COUNTY REMONUMENTATION
LAND CORNER RECORDATION CERTIFICATE
Filing Requirement of Act 74, Mich. P.A. 1970

For corners in

Ottawa (County)	Located in:	Corner Code #
1. Public Land Survey	T 8N R 14W	H-5 (S $\frac{1}{4}$, 10) Polkton Twp.
	T _____ R _____	_____
	T _____ R _____	_____
	T _____ R _____	_____
2. Property Controlling in Section	S _____ T _____ R _____	_____
	S _____ T _____ R _____	_____
3. Miscellaneous Property in Sec.	S _____ T _____ R _____	_____
	S _____ T _____ R _____	_____

RECORDED

96 NOV 14 AM 11:20

Elizabeth Robinson
REGISTER OF DEEDS
OTTAWA COUNTY, MI

Register of Deeds Stamp & File Number

4. Lot No. _____, Recorded Plat _____
5. Private Claims _____

I, Donald W. Schiele, in a field survey on October 18, 19 96, do hereby certify that under requirements of P.A. 74, Michigan P.A. of 1970, the corner points mentioned in lines 1 and 2 above were in conformance with regulations and rules therefore as required in the current manual of survey instructions of the United States Department of the Interior, Bureau of Land Management or by a decree of a Court of Law and/or that the corner points mentioned in lines 3, 4 and 5 above were in conformance with the rules of the Michigan Board of Land Surveyors or by a Decree of a Court of Law; established, re-established, monumented, re-monumented, recovered, found as expressed below:

	A	B	C	D	E	F	G	H	I	J	K	L
2	6	5	4	3	2	1						
3												
4	7	8	9	10	11	12						
5												
6	18	17	16	15	14	13						
7												
8	19	20	21	22	23	24						
9												
10	30	29	28	27	26	25						
11												
12	31	32	33	34	35	36						
13												

NOTE: Not more than 4 corners, all in the same town and range, may be recorded on this certificate.

A. Description of original monument and accessories and/or subsequent restoration:

H-5 1/4 corner common to Sections 10 & 15, Polkton Twp.
L.C.R.C. recorded in Remon Liber 1, Page 20, 9-29-93
C.I.M. 2" below surface
Set nail and Ottawa Co. re-mon. tag in North side of Power Pole S80°E 125.24'
Set nail and Ottawa Co. re-mon. tag in West side of 5" Elm S17°E 104.85'
Set nail and Ottawa Co. re-mon. tag in SW side of 12" Ash N69°W 40.86'
Set nail and Ottawa Co. re-mon. tag in SW side of Power Pole N37°W 250.30' (E)
CL North and South gravel road East 1'
On CL gravel road to East, on CL trail to West

B. Description of corner evidence found and/or method applied in restoring or reestablishing corner:

H-5 Found Cast Iron Monument (broken).
Found Ottawa County Remon Tag & nail in North side of Power Pole S80°E 125.22' (E)
Found Ottawa County Remon Tag & nail in SW side of 12" Ash N69°W 40.83' (E)
Found Ottawa County Remon Tag & nail in SW side of Power Pole N37°W 250.32' (E)
On centerline new gravel road North & South
On centerline gravel road East
On centerline trail West
Removed broken Cast Iron Monument, replaced with 3/4" X 24" steel bar with Ottawa County Remon Cap 2" below surface of gravel road and accepted as a careful and faithful perpetuation of the position of the original corner.


C. Description of monument for corner and accessories established to perpetuate locating the position of the corner:

H-5 3/4" X 24" steel bar with Ottawa County Remon Cap, 4" below surface of new asphalt road in Monument Box.
Ottawa County Remon Tag & nail in North side of Power Pole S80°E 125.22' (E)
Set Ottawa County Remon Tag & nail in West side of 5" Ash S23°30'E 102.42' (E)
Ottawa County Remon Tag & nail in SW side of 12" Ash N69°W 40.83' (E)
Ottawa County Remon Tag & nail in SW side of Power Pole N37°W 250.32' (E)
On centerline new asphalt road North & South
On centerline gravel road East
On centerline trail West

P.A. 345 OTTAWA COUNTY

PEER APPROVED 10-21-96

Signed by Donald W. Schiele
Surveyor's Michigan License No. 23517

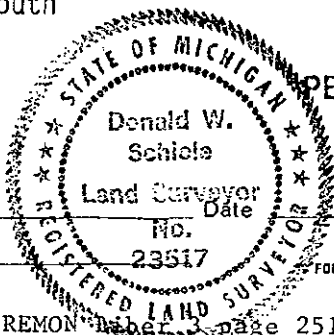

October 21, 1996