

FEB 24 2000

RECORDED

99 SEP 23 PM 3:21

SECTION

OTTAWA COUNTY REMONUMENTATION  
LAND CORNER RECORDATION CERTIFICATE  
Filing Requirement of Act 74, Mich. P.A. 1970

*Dany Schell*  
REGISTER OF DEEDS  
OTTAWA COUNTY, MI

For corners in

<u>Ottawa</u> (County)	Located in:	Corner Code #
	Crockery Township	
1. Public Land Survey	T <u>8NR</u> 15W	<u>A-1</u>
	T ___ R ___	<u>NW corner</u>
	T ___ R ___	<u>Section 6</u>
	T ___ R ___	_____
2. Property Controlling in Section	S ___ T ___ R ___	_____
	S ___ T ___ R ___	_____
3. Miscellaneous Property in Sec.	S ___ T ___ R ___	_____
	S ___ T ___ R ___	_____

Register of Deeds Stamp & File Number

4. Lot No. \_\_\_\_\_, Recorded Plat \_\_\_\_\_  
5. Private Claims \_\_\_\_\_

I, Carl P. Englert, in a field survey on 6/10, 1999 do hereby state that under requirements of P.A. 74, Michigan P.A. of 1970, the corner points mentioned in lines 1 and 2 above were in conformance with regulations and rules therefore as required in the current manual of survey instructions of the United States Department of the Interior, Bureau of Land Management or by a decree of a Court of Law and for that the corner points mentioned in lines 3, 4 and 5 above were in conformance with the rules of the Michigan Board of Land Surveyors or by a Decree of a Court of Law, established, re-established, monumented, recovered, found as expressed below:

NOTE: Not more than 2 corners, all in the same town and range, may be recorded on this certificate.

10	A	B	C	D	E	F	G	H	I	J	K	L	M
2	6		5		4		3		2		1		
3													
4	7		8		9		10		11		12		
5													
6	18		17		16		15		14		13		
7													
8	19		20		21		22		23		24		
9													
10	30		29		28		27		26		25		
11													
12	31		32		33		34		35		36		
13													

A. Description of original monument and accessories and/or subsequent restoration:

A-1 Corner to Towns 8 and 9 N, Ranges 15 and 16 W  
 John Mullett April, 1837 LCRC Liber 1056, Page 573  
 Beech 9 inch N13W 25 links Muskegon Co. Records J. Clapp 1975  
 Beech 16 inch S10E 48 links Found Iron Pipe  
 20" Oak SW 38.67'  
 12" Oak NE 30.59'  
 8" Pine NW 59.02'  
 18" Oak NE 75.74'  
 Triple 8" Cherry SE 72.40'

See Other Side


B. Description of corner evidence found and/or method applied in restoring or reestablishing corner:

A-1 Found 4" Harrison Cast Iron Monument with top broken off  
 4' West of centerline of asphalt pavement 0.6' below grade  
 Found Power Pole S45°E 42.73', Found Guy Pole S15°W 36.16'  
 Found 12" Oak N35°W 54.29', Found Twin Oak N35°E 54.62'

Accepted as a careful and faithful perpetuation of the original position of the corner.

C. Description of monument for corner and accessories established to perpetuate locating the position of the corner:

A-1 4" Harrison Cast Iron Monument  
 O.C. Remon Nail and Tag in W Side Guy Pole S24°W 36.07'  
 O.C. Remon Nail and Tag in SW Side P.P. S42°E 42.73'  
 O.C. Remon Nail and Tag in SE Side 28" Oak N46°E 54.42'  
 O.C. Remon Nail and Tag in SW Side 26" Oak N50°W 60.73'  
 Found 1/2" Capped Iron West 33.02'

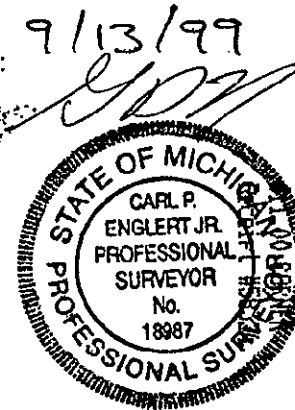

Signed by Carl P. Englert Jr.  
 Surveyor's Michigan License No. 18987

Date 9/13/1999

FEB 24 2000

SECTION

A-1 T8N, R15W

LCRC Liber 1118, Page 935 Muskegon Co. Records

Found 1/2" Rod

ENE 30.67' 14" Oak

SW 38.69' 20" Oak

NW 59.25' 10" Pine

Englert 1977

Liber 1240, Page 540, Muskegon Co. Records

Found 4" Cast Iron Monument

N68°E 30.67' 16" Oak

N37°E 75.74' 20" Oak

N36°W 59.20' 10" Pine

S24°W 36.20' Guy Pole

S42°E 42.75' P.P.

Lewandoski 1982

LCRC Liber 3, Page 226 Ottawa Co. Records

Replaced Iron Pipe with Cast Iron Monument

Inscribed "Ottawa County Section Corner"

20" Oak SW 38.70'

8" Pine NW 59.21'

12" Oak NE 30.59'

18" Oak NE 75.69'

Power Pole SE 42.27'

30" Oak SW 103.16'

Joiner 1977

LCRC Liber 6, Page 192, Ottawa Co. Records

Broken Cast Iron Monument

Nail in SW Side P.P. S45°E 42.73'

Nail in W Side Guy Pole S15°W 36.16'

P.K. Nail in NE Side 12" Oak N35°W 54.29'

P.K. Nail in SE Side 14"-22" Twin Oak N35°E 54.62'

Nail in face of 16" Oak N70°E 30.65'

Chris Marschall 1991