

FEB 27 1998

OTTAWA COUNTY REMONUMENTATION LAND CORNER RECORDATION CERTIFICATE Filing Requirement of Act 74, Mich. P.A. 1970

RECORDED

97 OCT 30 AM 11:01

For corners in SECTION

Ottawa (County)	Located In: Crockery Township	Corner Code #
1. Public Land Survey	T 8NR 15W	B-3
	T R	S 1/4 corner
	T R	Section 6
	T R	
	T R	
2. Property Controlling in Section	S T R	
	S T R	
3. Miscellaneous Property in Sec.	S T R	
	S T R	

*Debra Gant*  
Register of Deeds  
Ottawa County, MI

Register of Deeds Stamp & File Number

4. Lot No. \_\_\_\_\_, Recorded Plat \_\_\_\_\_  
5. Private Claims \_\_\_\_\_

I, Carl P. Englert, in a field survey on 2/28, 1997 do hereby state that under requirements of P.A. 74, Michigan P.A. of 1970, the corner points mentioned in lines 1 and 2 above were in conformance with regulations and rules therefore as required in the current manual of survey instructions of the United States Department of the Interior, Bureau of Land Management or by a decree of a Court of Law and/or that the corner points mentioned in lines 3, 4 and 5 above were in conformance with the rules of the Michigan Board of Land Surveyors or by a Decree of a Court of Law; established, re-established, monumented, recovered, found as expressed below:

1	A	B	C	D	E	F	G	H	I	J	K	L	M
2	6		5		4		3		2		1		
3	7		8		9		10		11		12		
4													
5													
6	18		17		16		15		14		13		
7													
8	19		20		21		22		23		24		
9													
10	30		29		28		27		26		25		
11													
12	31		32		33		34		35		36		
13													

NOTE: Not more than 2 corners, all in the same town and range, may be recorded on this certificate.

A. Description of original monument and accessories and/or subsequent restoration:

B-3 1/4 corner common to Sections 6 and 7  
 G.L.O. 1837 John Mullett LCRC Liber 1, Page 533 (7/19/73)  
 Set 1/4 Section Post Iron Pipe Old Ties  
 Pine 12" N66°W 1.04 chains E. to Concrete Mon. 16.5'  
 NE to 16" Oak 58.0'  
 Found 3/4" Pipe  
 NE 18" Oak 30.25'  
 NW 12" Oak 26.31'  
 SE to P.P. 38.55'

See Other Side

B. Description of corner evidence found and/or method applied in restoring or reestablishing corner:

B-3 1/4 corner common to Sections 6 and 7  
 Found 4" Harrison Cast Iron Monument with Broken Top 5" deep in Road Centerline  
 Witnesses destroyed by Road Construction  
 Angle at ~~NE~~ at NW Section corner checks 0°00'07" and distance 0.04' with a section breakdown done on 8/10/94 prior to the new construction

Accepted as a careful and faithful perpetuation of the original position of the corner.

C. Description of monument for corner and accessories established to perpetuate locating the position of the corner:

B-3 1/4 corner common to Sections 6 and 7  
 4" Harrison Cast Iron Monument with Broken Top  
 O.C. Remon Tag and Nail in West side of Power Pole N28°E 39.78'  
 O.C. Remon Tag and Nail in West side 18" Triple Oak N35°W 64.32'  
 O.C. Remon Tag and Nail in East side 16" Oak S30°W 53.54'  
 O.C. Remon Tag and Nail in NE side 21" Oak S42°E 58.39'


\$ 11.00 CORNER  
\$ 2.00 PHOTO

PEER APPROVED

9-15-97

Signed by Carl P. Englert  
Surveyor's Michigan License No. 18987

Date 9/11

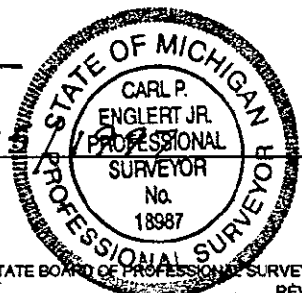

S 1/4 corner Section 6, Town 8 North, Range 15 West  
LCRC Liber 1, Page 733  
Found 1" Iron  
NW 10" Oak 26.33'  
NE 12" Oak 30.27'  
SE P.P. 38.73'

LCRC Liber 4, Page 239  
Found 3/4" Pipe, set Cast Iron Monument  
12" Oak NW 26.39'  
Power Pole SE 38.67'  
Power Pole NE 40.51'  
16" Oak NE 30.30'

**SURVEY &  
REMONUMENTATION**

**FEB 27 1998**

**SECTION**