

# SURVEY & REMONUMENTATION

**FEB 27 1998**

OTTAWA COUNTY REMONUMENTATION  
LAND CORNER RECORDATION CERTIFICATE  
Filing Requirement of Act 74, Mich. P.A. 1970

**RECORDED**

97 OCT 30 AM 11:01

For corners in

**SECTION**

<u>Ottawa</u> <small>(County)</small>	Located In: <b>Crockery Township</b>	Corner Code #  <u>B-5</u>
1. Public Land Survey	T <u>8N</u> R <u>15W</u>	<u>S 1/4</u> corner
	T ___ R ___	<u>Section 7</u>
	T ___ R ___	_____
	T ___ R ___	_____
2. Property Controlling in Section	S ___ T ___ R ___	_____
	S ___ T ___ R ___	_____
3. Miscellaneous Property in Sec.	S ___ T ___ R ___	_____
	S ___ T ___ R ___	_____

*Debra Gant*  
**Register of Deeds  
Ottawa County, MI**

**Register of Deeds Stamp & File Number**

4. Lot No. \_\_\_\_\_, Recorded Plat \_\_\_\_\_  
5. Private Claims \_\_\_\_\_

I, Carl P. Englert, in a field survey on 2/28, 19 97 do hereby state that under requirements of P.A. 74, Michigan P.A. of 1970, the corner points mentioned in lines 1 and 2 above were in conformance with regulations and rules therefore as required in the current manual of survey instructions of the United States Department of the Interior, Bureau of Land Management or by a decree of a Court of Law and/or that the corner points mentioned in lines 3, 4 and 5 above were in conformance with the rules of the Michigan Board of Land Surveyors or by a Decree of a Court of Law; established, re-established, monumented, recovered, found as expressed below:

**NOTE:** Not more than 2 corners, all in the same town and range, may be recorded on this certificate.

	A	B	C	D	E	F	G	H	I	J	K	L	M
1													
2	6	5	4	3	2	1							
3													
4	7	8	9	10	11	12							
5	⊙												
6	18	17	16	15	14	13							
7													
8	19	20	21	22	23	24							
9													
10	30	29	28	27	26	25							
11													
12	31	32	33	34	35	36							
13													

A. Description of original monument and accessories and/or subsequent restoration:

B-5 1/4 corner common to Sections 7 & 18  
 G.L.O. 1837 John Mullett LCRC Liber 1, Page 56 (8/1/72)  
 Set 1/4 Section Post Found "T" Iron  
 Pine 15" S37°W 31 links NE Cor. House No. 14030 SW 77.30'  
 Pine 13" N65°E 70 links SE Cor. House No. 14031 NW 61.25'  
 SW Cor. House No. 14031 NW 71.04'

See Other Side

B. Description of corner evidence found and/or method applied in restoring or reestablishing corner:

B-5 1/4 corner common to Sections 7 & 18  
 Found 4" Harrison Cast Iron Monument in Monument Box  
 Found SW House corner (#14031) NW 71.04'  
 Found SE House corner (#14031) NW 61.30'  
 Found NE House corner (#14030) SW 77.18'  
 Found PK in P.P. North 55.38'


PA. 345 OTTAWA COUNTY

PEER APPROVED 9-15-97  
*[Signature]*

Accepted as a careful and faithful perpetuation of the original position of the corner

C. Description of monument for corner and accessories established to perpetuate locating the position of the corner:

B-5 1/4 corner common to Sections 7 & 18  
 4" Harrison Cast Iron Monument in Mon. Box 3" deep in Road Centerline  
 O.C. Remon Tag & Nail in W Side 14" Maple S36°E 52.06'  
 O.C. Remon Tag & Nail in NW Side 11" Spruce S50°W 54.12'  
 O.C. Remon Tag & Nail in E Side Power Pole N 4°W 55.35'  
 O.C. Remon Tag & Nail in NW Side 28" Oak N55°E 98.92'

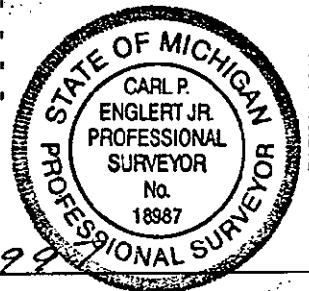

\$ 11.00 CORNER  
\$ 2.00 PHOTO

Signed by Carl P. Englert Jr.  
 Surveyor's Michigan License No. 18987

Date 9/15/1997

S 1/4 Cor. Sec 7 Town 8 North, Range 15 West  
LCRC Liber 3, Page 234 (12/21/77)  
SW Corner House No. 14031 NW 71.04'  
SE Corner House No. 14031 NW 61.30'  
NE Corner House, No. 14030 SW 77.18'  
PK in Power Pole N 55.38'

**SURVEY &  
REMONUMENTATION**

**FEB 27 1998**

**SECTION**