

**SURVEY & REMONUMENTATION**

**FEB 27 1998**

**OTTAWA COUNTY REMONUMENTATION LAND CORNER RECORDATION CERTIFICATE**  
Filing Requirement of Act 74, Mich. P.A. 1970

**RECORDED**

**97 OCT 30 AM 11:01**

**SECTION**

For corners in

<u>Ottawa</u> (County)	Located in:	Corner Code #
	Crockery Township	
1. Public Land Survey	T8N R15W	B-7
	T___ R___	S 1/4 corner
	T___ R___	Section 18
	T___ R___	_____
2. Property Controlling in Section	S___ T___ R___	_____
	S___ T___ R___	_____
3. Miscellaneous Property in Sec.	S___ T___ R___	_____
	S___ T___ R___	_____
4. Lot No. _____, Recorded Plat _____		
5. Private Claims _____		

*Debra Gant*

Register of Deeds  
Ottawa County, MI

Register of Deeds Stamp & File Number

A	B	C	D	E	F	G	H	I	J	K	L	M
1												
2	6	5	4	3	2	1						
3												
4	7	8	9	10	11	12						
5												
6	18	17	16	15	14	13						
7	19	20	21	22	23	24						
8												
9												
10	30	29	28	27	26	25						
11												
12	31	32	33	34	35	36						
13												

I, Carl P. Englert, in a field survey on 2/28, 1997 do hereby state that under requirements of P.A. 74, Michigan P.A. of 1970, the corner points mentioned in lines 1 and 2 above were in conformance with regulations and rules therefore as required in the current manual of survey instructions of the United States Department of the Interior, Bureau of Land Management or by a decree of a Court of Law and/or that the corner points mentioned in lines 3, 4 and 5 above were in conformance with the rules of the Michigan Board of Land Surveyors or by a Decree of a Court of Law, established, re-established, monumented, recovered, found as expressed below:

NOTE: Not more than 2 corners, all in the same town and range, may be recorded on this certificate.

A. Description of original monument and accessories and/or subsequent restoration:

B-7 1/4 corner common to Sections 18 & 19  
G.L.O. 1837 John Mullett  
Set 1/4 Section Post  
Pine 20" S39°E 59 links  
Pine 16" N8°W 16 links  
LCRC Liber 2, Page 61 (2/16/73)  
Found 3/4" Rod in Mon. Box  
SW 46.74' P.P.  
SE 38.43' 24" Oak

B. Description of corner evidence found and/or method applied in restoring or reestablishing corner:

B-7 1/4 corner common to Sections 18 & 19  
Found 3/4 Iron Bar in Monument Box in centerline of E.W. Pavement  
Found Power Pole S.W. 46.74'  
Found 24" Oak S.E. 38.43'  
P.A. 343 OTTAWA COUNTY  
PEER APPROVED 9-15-97


Accepted as a careful and faithful perpetuation of the original position of the corner.

C. Description of monument for corner and accessories established to perpetuate locating the position of the corner:

B-7 1/4 corner common to Sections 18 & 19  
Set O.C. Remon Cap on existing 3/4" Iron Bar in Mon. Box  
O.C. Remon Tag & Nail in E Side Power Pole S34°W 46.85'  
O.C. Remon Tag & Nail in SW Side of 16" Oak S32°E 55.88'  
O.C. Remon Tag & Nail in NW Side Power Pole N49°E 79.30'  
O.C. Remon Tag & Nail in SW Side of 48" Oak N58°W 138.26'

Signed by Carl P. Englert  
Surveyor's Michigan License No. 18987

Date 9/15/1997

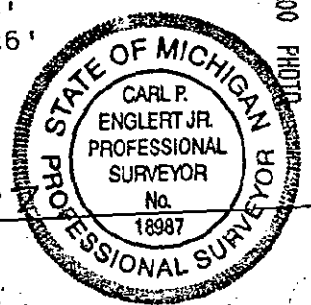

\$ 9.00 CORNER  
\$ 1.00 PHOTO