

FEB 27 1998

FEB 27 1998

OTTAWA COUNTY REMONUMENTATION LAND CORNER RECORDATION CERTIFICATE Filing Requirement of Act 74, Mich. P.A. 1970

SECTION

RECORDED

97 OCT 30 AM 11:01

Debra Gant

Register of Deeds Ottawa County, MI

Register of Deeds Stamp & File Number

For corners in

<u>Ottawa</u> (County)	Located In: Crockery Township	Corner Code # B-9 S 1/4 corner Section 19
1. Public Land Survey	T 8N R 15W T ___ R ___ T ___ R ___ T ___ R ___	_____
2. Property Controlling in Section	S ___ T ___ R ___ S ___ T ___ R ___	_____
3. Miscellaneous Property in Sec.	S ___ T ___ R ___ S ___ T ___ R ___	_____

4. Lot No. _____, Recorded Plat _____
5. Private Claims _____

I, Carl P. Englert, in a field survey on 3/5, 1997 do hereby state that under requirements of P.A. 74, Michigan P.A. of 1970, the corner points mentioned in lines 1 and 2 above were in conformance with regulations and rules therefore as required in the current manual of survey instructions of the United States Department of the Interior, Bureau of Land Management or by a decree of a Court of Law and /or that the corner points mentioned in lines 3, 4 and 5 above were in conformance with the rules of the Michigan Board of Land Surveyors or by a Decree of a Court of Law; established, re-established, monumented, recovered, found as expressed below:

NOTE: Not more than 2 corners, all in the same town and range, may be recorded on this certificate.

A	B	C	D	E	F	G	H	I	J	K	L	M
1												
2	6	5	4	3	2	1						
3												
4	7	8	9	10	11	12						
5												
6	18	17	16	15	14	13						
7												
8	19	20	21	22	23	24						
9	30	29	28	27	26	25						
10												
11												
12	31	32	33	34	35	36						
13												

A. Description of original monument and accessories and/or subsequent restoration:

- B-9 1/4 corner common to Sections 19 & 30
- G.L.O. 1832 John Mullett LCRC Liber 1, Page 519 (8/13/72)
- Set 1/4 Section Post Found Iron Pipe in Centerline of Road
- Sugar 11" N80°E 24 links Power Pole NW 66.38'
- Beech 7" S81°W 21 links Power Pole NE 101.18'
- Power Pole SE 100.52'

See Other Side

B. Description of corner evidence found and/or method applied in restoring or reestablishing corner:

- B-9 1/4 corner common to Sections 19 & 30
- Found 2 1/2" Harrison Cast Iron Monument in Monument Box 4" deep
- in Road Centerline
- Found Power Pole SE 100.96'


P.A. 345 OTTAWA COUNTY

PEER APPROVED 9-15-97

Accepted as a careful and faithful perpetuation of the original position of the corner.

C. Description of monument for corner and accessories established to perpetuate locating the position of the corner:

- B-9 1/4 corner common to Sections 19 & 30
- 2 1/2" Harrison Cast Iron Monument in Monument Box
- O.C. Remon Tag & Nail in SE Side 8" Cedar N43°E 49.39'
- O.C. Remon Tag & Nail in SW Side Power Pole S64°E 100.94'
- O.C. Remon Tag & Nail in SE Side Power Pole S72°W 160.54'
- O.C. Remon Tag & Nail in SW Side 8" Aspen N34°W 51.85'

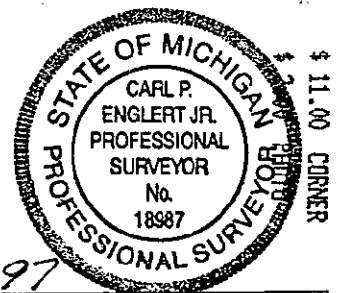

Signed by Carl P. Englert Jr. Surveyor's Michigan License No. 18987

Date 9/15/1997

B-9 Town 8 North, Range 15 West
LCRC Liber 5, Page 91 (12/20/83)
Found 1" Iron in Mon. Box, Set Cast Iron Mon.
Tele. Pole NE 101.50'
Power Pole SE 100.96'
6" Aspen NW 55.81'
Fence Post SW 55.00'

**SURVEY &
REMONUMENTATION**

FEB 27 1998

SECTION