

SURVEY & REMONUMENTATION

FEB 27 1998

SECTION

OTTAWA COUNTY REMONUMENTATION
LAND CORNER RECORDATION CERTIFICATE
Filing Requirement of Act 74, Mich. P.A. 1970

RECORDED

97 OCT 30 AM 11:00

For corners in

<u>Ottawa</u> (County)	Located in: Crockery Township	Corner Code # <u>B-11</u> <u>S 1/4 corner</u> <u>Section 30</u>
1. Public Land Survey	T <u>8N</u> R <u>15W</u>	
	T ___ R ___	
	T ___ R ___	
	T ___ R ___	
2. Property Controlling in Section	S ___ T ___ R ___	
	S ___ T ___ R ___	
3. Miscellaneous Property in Sec.	S ___ T ___ R ___	
	S ___ T ___ R ___	
4. Lot No. _____, Recorded Plat _____		
5. Private Claims _____		

Debra Gant

Register of Deeds
Ottawa County, MI

Register of Deeds Stamp & File Number

I, Carl P. Englert, in a field survey on 2/28, 1997 do hereby state that under requirements of P.A. 74, Michigan P.A. of 1970, the corner points mentioned in lines 1 and 2 above were in conformance with regulations and rules therefore as required in the current manual of survey instructions of the United States Department of the Interior, Bureau of Land Management or by a decree of a Court of Law and for that the corner points mentioned in lines 3, 4 and 5 above were in conformance with the rules of the Michigan Board of Land Surveyors or by a Decree of a Court of Law; established, re-established, monumented, recovered, found as expressed below:

NOTE: Not more than 2 corners, all in the same town and range, may be recorded on this certificate.

	A	B	C	D	E	F	G	H	I	J	K	L	M
1													
2	6	5	4	3	2	1							
3													
4	7	8	9	10	11	12							
5													
6	18	17	16	15	14	13							
7													
8	19	20	21	22	23	24							
9													
10	30	29	28	27	26	25							
11	31	32	33	34	35	36							
12													
13													

A. Description of original monument and accessories and/or subsequent restoration:

B-11 1/4 corner common to Sections 30 and 31
G.L.O. 1837 John Mullett
Set 1/4 Section Post
B. Oak 12" N25°E 10 links
Pine 30" S44°W 37 links
LCRC Liber 1, Page 519 (8/13/72)
Found Iron Pipe
18" Oak NE 98.61'
36" Oak W 20.79'
16" Oak NW 75.63'
Power Pole South 108.57'

B. Description of corner evidence found and/or method applied in restoring or reestablishing corner:


B-11 1/4 corner common to Sections 30 and 31
Found 4" Harrison Cast Iron Monument
Found 36" Oak W 20.79'
Found 16" White Pine NE 43.73'
Found Power Pole S 108.57'

PA. 345 OTTAWA COUNTY
PEER APPROVED 9-15-97
[Signature]

Accepted as a careful and faithful perpetuation of the original position of the corner.

C. Description of monument for corner and accessories established to perpetuate locating the position of the corner:

B-11 1/4 corner common to Sections 30 and 31
4" Harrison Cast Iron Monument
O.C. Remon Tag & Nail in W Side Power Pole S100°E 108.73'
O.C. Remon Tag & Nail in N Side 17" Oak N80°W 51.56'
O.C. Remon Tag & Nail in W Side 25" W. Pine N100°E 44.40'
O.C. Remon Tag & Nail in SW Side 16" W. Pine S58°E 73.04'

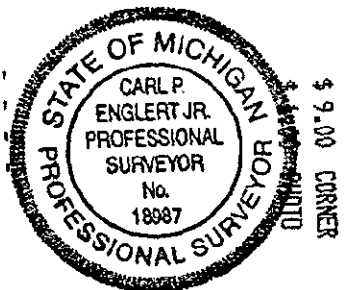

Signed by Carl P. Englert Jr.
Surveyor's Michigan License No. 18987

Date 9/15/1997