

SURVEY & REMONUMENTATION

DEC 01 1998

SECTION

**OTTAWA COUNTY REMONUMENTATION
LAND CORNER RECORDATION CERTIFICATE
Filing Requirement of Act 74, Mich. P.A. 1970**

For corners in

<u>Ottawa</u> (County)	Located In:	Corner Code #
1. Public Land Survey	T 8 N R 15 W	<u>B-13</u>
	T <u>7N</u> R <u>15W</u>	<u>B-1</u>
	T _____ R _____	_____
	T _____ R _____	_____
2. Property Controlling in Section	S _____ T _____ R _____	South 1/4 corner
	S _____ T _____ R _____	Section 31
3. Miscellaneous Property in Sec.	S _____ T _____ R _____	Crockery Twp
	S _____ T _____ R _____	_____

RECORDED
98 JUL 24 PM 1:45

Sam [Signature]
REGISTER OF DEEDS
OTTAWA COUNTY, MI

Register of Deeds Stamp & File Number

4. Lot No. _____, Recorded Plat _____
5. Private Claims _____

1	A	B	C	D	E	F	G	H	I	J	K	L	M
2	6	5	4	3	2	1							
3													
4	7	8	9	10	11	12							
5													
6	18	17	16	15	14	13							
7													
8	19	20	21	22	23	24							
9													
10	30	29	28	27	26	25							
11													
12	31	32	33	34	35	36							
13													

I, Steve Lampen, in a field survey on June 10 19 98, do hereby certify that under requirements of P.A. 74, Michigan P.A. of 1970, the corner points mentioned in lines 1 and 2 above were in conformance with regulations and rules therefore as required in the current manual of survey instructions of the United States Department of the Interior, Bureau of Land Management or by a decree of a Court of Law and/or that the corner points mentioned in lines 3, 4 and 5 above were in conformance with the rules of the Michigan Board of Land Surveyors or by a Decree of a Court of Law; established, re-established, monumented, re-monumented, recovered, found as expressed below:

NOTE: Not more than 4 corners, all in the same town and range, may be recorded on this certificate.

A. Description of original monument and accessories and/or subsequent restoration:

B-13 GLO-Britain-1832 West on S. side Sec. 31 40.00 set 1/4 sec. post Pine 10 N 2 E 11.00 lks 67.70 to Grand River And raised a mound	GLO Plat - T7N, R15W C-1 to B-1 = 40.00 ch. GLO - T8N, R15W C-13 to B-13 = 40.00 ch. B-13 to A-13 = 39.30 ch.	Surveys by Peck- T7N, R15W C-1 to B-1 = 40.00 ch. B-1 to A-1 = 40.23 ch. B-1 to B-2 = 39.80 ch. C-13, T8N, R15W to B-13 = 40.00 ch. B-13 to A-13 = 40.23 ch.
---	---	--

Mullet - 1837
79.30 intersect range line 20 lks North of temporary 6 mile post and set corner to T7 & 8N, R15 & 16W raised a mound.

B. Description of corner evidence found and/or method applied in restoring or reestablishing corner:


B-13
Historically C-1 T7N, R15W has been used as common with C-13 T8N, R15W.
Peck held C-1 and C-13 common and also held B-1 and B-13 common.
Calculated the North and South position of B-13 by extending the Section line West from C-13 through iron found 1326.4 ft and 2204.2 ft West of C-13.
Calculated East and West position of C-13 by proportioning Peck's distances of C-13 to B-13 = 40.00 ch. and B-13 to A-13 = 40.23 ch. Peck = 80.23 ch. = 5295.18 ft. Measure = 5297.24 ft.
Calculated position is on line (± 0.3ft) with historical monument at B-2 and the historical SW corner of the NW 1/4 NE 1/4 Section 6.
See sketch on back.
Set an Ottawa County Remonumentation iron and cap and is accepted as the best position of the corner.

PA. 375 OTTAWA COUNTY
PECK APPROVED 6-15-98
[Signature]

C. Description of monument for corner and accessories established to perpetuate locating the position of the corner:

B-13
Ottawa County Remonumentation Iron and Cap.
B-1 T7N, R15W is common with B-13 T8N, R15W
Azimuth = Michigan State Plane Grid Direction

Remonumentation tag in SW side	6" Poplar	142° 48'	115.17
Remonumentation tag in SW side	8" Willow	133° 38'	163.84
Remonumentation tag in NE side	10" Willow	158° 06'	180.54
Pk nail	NW side	Light pole	193° 07'

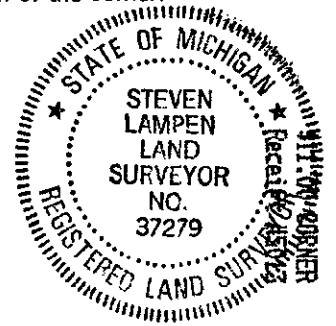

Signed by Steven Lampen Date July 20, 1998
Surveyor's Michigan License No. 37279

FORM APPROVED BY MICHIGAN STATE BOARD OF LAND SURVEYORS, JAN. 28, 1971
REVISED MAY 14, 1975
REVISED JAN., 1983
ADAPTED FOR WORD PROCESSING MARCH, 1993



SURVEY &
REMONUMENTATION

DEC 01 1998

SECTION

