

SURVEY & REMONUMENTATION

APR 24 1995

OTTAWA COUNTY REMONUMENTATION LAND CORNER RECORDATION CERTIFICATE

RECORDED

94 DEC 15 AM 11:51

For corners in **COMMISSION**

Phyllis Redman
REGISTER OF DEEDS
OTTAWA COUNTY, MI

<u>Ottawa</u> (County)	Located In: Crockery Twp.	Corner Code # <u>C-3</u>
1. Public Land Survey	T <u>8N</u> R <u>15W</u>	<u>NW Corner</u>
	T _____ R _____	<u>Section 8</u>
	T _____ R _____	_____
	T _____ R _____	_____
2. Property Controlling in Section	S _____ T _____ R _____	_____
	S _____ T _____ R _____	_____
3. Miscellaneous Property in Sec.	S _____ T _____ R _____	_____
	S _____ T _____ R _____	_____
4. Lot No. _____, Recorded Plat _____		
5. Private Claims _____		

Register of Deeds Stamp & File Number

A	B	C	D	E	F	G	H	I	J	K	L	M
2	6	5	4	3	2	1						
3												
4	7	8	9	10	11	12						
5												
6	18	17	16	15	14	13						
7												
8	19	20	21	22	23	24						
9												
10	30	29	28	27	26	25						
11												
12	31	32	33	34	35	36						
13												

I, Carl P. Englert, in a field survey on November 30, 1994, do hereby certify that under requirements of P.A. 74, Michigan P.A. of 1970, the corner points mentioned in lines 1 and 2 above were in conformance with regulations and rules therefore as required in the current manual of survey instructions of the United States Department of the Interior, Bureau of Land Management or by a decree of a Court of Law and/or that the corner points mentioned in lines 3, 4 and 5 above were in conformance with the rules of the Michigan Board of Land Surveyors or by a Decree of a Court of Law; established, re-established, monumented, re-monumented, recovered, found as expressed below:

NOTE: Not more than 4 corners, all in the same town and range, may be recorded on this certificate.

A. Description of original monument and accessories and/or subsequent restoration:

C-3 corner common to Sections 5,6,7 & 8
Original gov't corner set March 1837
by John Mullet D.S.

LCRC Liber 3, Page 227 (11/14/77)
C-3) Replaced Rubber Coated Rod With
Cast Iron Monument Inscribed "Ottawa
County Section Corner."
Ties:
TRI 18" Maple SW 135.82
NW Corner Headwall SE 67.50
9" Tree NW 33.09

Set Post

B. Ash 8" S31°W 12 Links
B. Ash 8" S83°E 12 Links

(See Back of Page)

B. Description of corner evidence found and/or method applied in restoring or reestablishing corner:

C-3 Corner common to Sections 5,6,7 & 8

Found 4" Harrison Cast Iron Mon. with Broken Top 3" deep, 3'+/- N. of
Road E
Found Trip. 18" Maple SW 135.82
Found NW corner Headwall SE 67.50

P.A. 345 OTTAWA COUNTY

PEER APPROVED 12/12/94

Accepted as a careful and faithful perpetuation of the original position of the corner.


C. Description of monument for corner and accessories established to perpetuate locating the position of the corner:

C-3 corner common to Sections 5,6,7 & 8

4" Harrison Cast Iron Mon. with top broken off
O.C. Remon. Tag & Nail in SE side 20" Trip. Maple S75°W 136.00'
O.C. Remon. Tag & Nail in E side 15" Elm N 3°W 23.79'
O.C. Remon. Tag & Nail in N side 12" Cherry S76°E 92.12'
Cut cross E Conc. End Wall S 5°E 118.32'
Cut cross E Conc. End Wall S36°E 72.02'

Signed by Carl P. Englert Jr.
Surveyor's Michigan License No. 18987

Date 12/5/94

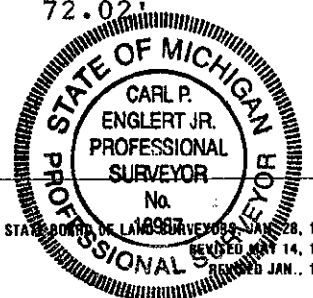

FORM APPROVED BY MICHIGAN STATE BOARD OF LAND SURVEYORS, JAN. 28, 1971
REVISED MAY 14, 1975
REVISED JAN., 1983

LCRC Liber 1, Page 509 (6/26/72)

C-3

Fd 1/2" Rubber Coated Rod

Triple 18" Maple	SW	135.75'
Power Pole	SW	155.60'
N.End Expansion Joint	SSW	57.80'
N.End Expansion Joint	W	96.60'
NW corner Headwall	SE	67.50'
⊗ 24" CMP Culbert	E	11.0'

100 #
150 #
