

SURVEY & REMONUMENTATION

APR 24 1995

COMMISSION

OTTAWA COUNTY REMONUMENTATION
LAND CORNER RECORDATION CERTIFICATE
Filing Requirement of Act 74, Mich. P.A. 1970

RECORDED

94 DEC 15 AM 11:52

For corners in

Ottawa
(County)

Located In:
Crockery Twp.

Corner Code #

- | | | |
|------------------------------------|--------------------------|-----------|
| 1. Public Land Survey | T <u>8N</u> R <u>15W</u> | C-5 |
| | T _____ R _____ | SW Corner |
| | T _____ R _____ | Section 8 |
| | T _____ R _____ | |
| 2. Property Controlling in Section | S _____ T _____ R _____ | |
| | S _____ T _____ R _____ | |
| 3. Miscellaneous Property in Sec. | S _____ T _____ R _____ | |
| | S _____ T _____ R _____ | |

Phyllis Holman
REGISTER OF DEEDS
OTTAWA COUNTY, MI

Register of Deeds Stamp & File Number

4. Lot No. _____, Recorded Plat _____
5. Private Claims _____

I, Carl P. Englert in a field survey on November 30, 1994, do hereby certify that under requirements of P.A. 74, Michigan P.A. of 1970, the corner points mentioned in lines 1 and 2 above were in conformance with regulations and rules therefore as required in the current manual of survey instructions of the United States Department of the Interior, Bureau of Land Management or by a decree of a Court of Law and/or that the corner points mentioned in lines 3, 4 and 5 above were in conformance with the rules of the Michigan Board of Land Surveyors or by a Decree of a Court of Law; established, re-established, monumented, re-monumented, recovered, found as expressed below:

	A	B	C	D	E	F	G	H	I	J	K	L	M
2	6	5	4	3	2	1							
3													
4	7	8	9	10	11	12							
5													
6	18	17	16	15	14	13							
7													
8	19	20	21	22	23	24							
9													
10	30	29	28	27	26	25							
11													
12	31	32	33	34	35	36							
13													

NOTE: Not more than 4 corners, all in the same town and range, may be recorded on this certificate.

A. Description of original monument and accessories and/or subsequent restoration:

C-5 corner common to Sections 7, 8, 17 & 18
Original Gov't corner set March, 1837
by John Mullet D.S.

LCRC Liber 3, Page 234 11/14/77
C-5) Replaced iron pipe with cast iron monument inscribed "Ottawa County Section Corner."

Set Post

Pine 24" N60E 33 Links
W. Oak 14" S20E 32 Links

Ties:

SE House Corner	NW	114.88
18" Oak	NE	84.76
10" Pine	NE	53.00
Power Pole	SE	84.56

(See Back of Page)

B. Description of corner evidence found and/or method applied in restoring or reestablishing corner:

C-5 corner common to Sections 7, 8, 17 & 18

Found 4" Harrison Cast Iron Mon. in Mon. Box 7" Deep, 6'+/- N. of Road E
Found 28" Pine NE 61.46'
Found SE corner of House NW 114.9'

P.A. 345 OTTAWA COUNTY
PEER APPROVED 12/12/94
Arden D. Hedwood


Accepted as a careful and faithful perpetuation of the original position of the corner.

C. Description of monument for corner and accessories established to perpetuate locating the position of the corner:

C-5 corner common to Sections 7, 8, 17 & 18

4" Harrison Cast Iron Mon. in Mon. Box		
O.C. Remon. Tag & Nail in S.W. side 10" Spruce	N40W	42.10'
O.C. Remon. Tag & Nail in S.E. side 26" W. Pine	N28E	61.56'
O.C. Remon. Tag & Nail in N.E. side 8" Sassafras	S51E	64.48'
O.C. Remon. Tag & Nail in N.W. side 16" Oak	S49W	82.90'
Top Center of Hydrant	N45E	61.53'

Signed by Carl P. Englert Date 12/5/94
Surveyor's Michigan License No. 18987

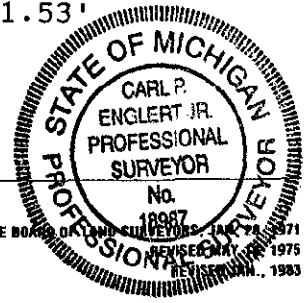

FORM APPROVED BY MICHIGAN STATE BOARD OF LAND SURVEYORS, JAN 28 1971
REVISED MAY 1975
REVISION JAN., 1983

LCRC Liber 1, Page 267 2/2/72

C-5 Found Boat Spike

Nail in the Face of Tel. Pole	S.W.	49.82'
Nail in the Face of P.P.	N.E.	93.72'
Nail in the Face of 10" Pine	N.E.	61.46'
Nail in the Face of P.P.	S.E.	84.56'
S.E. House Corner	N.W.	114.88'

LCRC Liber 3, Page 170 7/28/77

C-5 Boat Spike

P.P.	N.E.	93.12'
18" Pine	N.E.	61.46'
S.E. Corner Hse.	N.W.	114.88'
Tel. Pole	E.S.E.	84.65'
St. Sign	S.E.	43.12'
Tel. Pole	S.W.	50.91'