

OTTAWA COUNTY REMONUMENTATION
 LAND CORNER RECORDATION CERTIFICATE
 Filing Requirement of Act 74, Mich. P.A. 1970

RECORDED
 99 SEP 23 PM 3: 22

For corners in

Ottawa Located In: Crockery Township Corner Code #
 (County)

1. Public Land Survey T 8N R 15W C-6
 T R E 1/4 Corner
 T R Section 18
 T R
 2. Property Controlling S T R
 in Section S T R
 3. Miscellaneous S T R
 Property in Sec. S T R

Lang Sublett
 REGISTER OF DEEDS
 OTTAWA COUNTY, MI

SURVEY &
 REMONUMENTATION

DEC 05 2000

SECTION

Register of Deeds Stamp & File Number

4. Lot No. _____, Recorded Plat _____
 5. Private Claims _____

I, Carl P. Englert, in a field survey on 8/20, 1999, do hereby state that under requirements of P.A. 74, Michigan P.A. of 1970, the corner points mentioned in lines 1 and 2 above were in conformance with regulations and rules therefore as required in the current manual of survey instructions of the United States Department of the Interior, Bureau of Land Management or by a decree of a Court of Law and for that the corner points mentioned in lines 3, 4 and 5 above were in conformance with the rules of the Michigan Board of Land Surveyors or by a Decree of a Court of Law, established, re-established, monumented, recovered, found as expressed below:

NOTE: Not more than 2 corners, all in the same town and range, may be recorded on this certificate.

	A	B	C	D	E	F	G	H	I	J	K	L	M
1													
2	6		5		4		3		2		1		
3													
4	7		8		9		10		11		12		
5													
6	18	17	16	15	14	13							
7													
8	19	20	21	22	23	24							
9													
10	30	29	28	27	26	25							
11													
12	31	32	33	34	35	36							
13													

A. Description of original monument and accessories and/or subsequent restoration:

C-6 1/4 Section corner common to Sections 17 & 18
 G.L.O. John Mullett, 1837 L.C.R.C. Liber 1, Page 56 Mr. Greer 1972
 Set 1/4 Section Post Found Steel Bar
 Pine 18" S66°W 12 Links 6" Oak NE 20.05'
 Pine 22" N33°E 07 Links 6" Pine SSE 44.17'
 6" Pine WSW 58.38'

See Other Side

B. Description of corner evidence found and/or method applied in restoring or reestablishing corner:

C-6 Found 4" Broken Cast Iron Monument
 Found 15" Oak NE 20'± (No Nail)
 Found 10" Twin Oak 26'± (No Nail)
 Found 1-1/2" Iron Pipe West 33.00'

RECEIVED 8/16/99
[Signature]


Accepted as a careful and faithful perpetuation of the original position of the corner.

C. Description of monument for corner and accessories established to perpetuate locating the position of the corner:

C-6 4" Harrison Cast Iron Monument with Top Section Broken Off
 O.C. Remon. Nail & Tag in W Side 8" Twin Oak N25°E 82.62'
 O.C. Remon. Nail & Tag in SE Side 15" Oak N60°E 20.55'
 O.C. Remon. Nail & Tag in SW Side 10" Twin Oak S45°E 26.45'
 O.C. Remon. Nail & Tag in N Side 14" Oak S80°W 53.89'
 1-1/2" Iron Pipe West 33.00'

Signed by Carl P. Englert
 Surveyor's Michigan License No. 18987

Date 8/13/1999

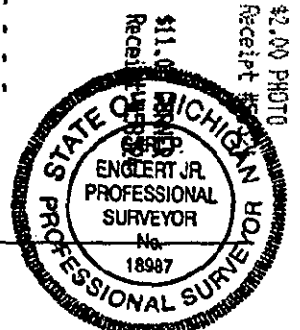

SURVEY &
REMONUMENTATION

DEC 9 5 2000

SECTION

C-6 T8N, R15W

LCRC Liber 4, Page 68, Mr. Joiner, May 1980
Found Rubber Coated Rod, Set Cast Iron Monument
inscribed "Section Corner".

8" Oak NE 20.02'
Twin 5" Oak SE 25.92'
Twin 10" Oak SSW 39.24'
19" Oak NW 57.82'
1-1/2" Pipe West 33.00'