

SURVEY & REMONUMENTATION

APR 24 1995

OTTAWA COUNTY REMONUMENTATION
LAND CORNER RECORDATION CERTIFICATE
Filing Requirement of Act 74, Mich. P.A. 1970

RECORDED

94 DEC 15 AM 11:52

D. J. Hallman
REGISTER OF DEEDS
OTTAWA COUNTY, MI

For corners in **COMMISSION**

<u>Ottawa</u> <small>(County)</small>	Located In: Crockery Twp.	Corner Code #
1. Public Land Survey	T <u>8N</u> R <u>15W</u>	<u>C-8</u>
	T _____ R _____	<u>W 1/4 Corner</u>
	T _____ R _____	<u>Section 20</u>
	T _____ R _____	_____
2. Property Controlling in Section	S _____ T _____ R _____	_____
	S _____ T _____ R _____	_____
3. Miscellaneous Property in Sec.	S _____ T _____ R _____	_____
	S _____ T _____ R _____	_____
4. Lot No. _____, Recorded Plat _____		
5. Private Claims _____		

Register of Deeds Stamp & File Number

I, Carl P. Englert, in a field survey on December 05, 19 94, do hereby certify that under requirements of P.A. 74, Michigan P.A. of 1970, the corner points mentioned in lines 1 and 2 above were in conformance with regulations and rules therefore as required in the current manual of survey instructions of the United States Department of the Interior, Bureau of Land Management or by a decree of a Court of Law and/or that the corner points mentioned in lines 3, 4 and 5 above were in conformance with the rules of the Michigan Board of Land Surveyors or by a Decree of a Court of Law; established, re-established, monumented, re-monumented, recovered, found as expressed below:

NOTE: Not more than 4 corners, all in the same town and range, may be recorded on this certificate.

	A	B	C	D	E	F	G	H	I	J	K	L	M
2	6	5	4	3	2	1							
3													
4	7	8	9	10	11	12							
5													
6	18	17	16	15	14	13							
7													
8	19	▲	20	21	22	23	24						
9													
10	30	29	28	27	26	25							
11													
12	31	32	33	34	35	36							
13													

A. Description of original monument and accessories and/or subsequent restoration:
 C-8 1/4 corner common to Sections 19 & 20 LCRC Liber 3, Page 225 (11/14/77)
 Original Gov't corner set March, 1837 C-8) Replaced Heretofore Mentioned
 by John Mullet D.S. Articles with cast iron Monument
 Inscribed "Ottawa County Section
 Corner."
 Pine 10" 1/4 Section Corner
 Ties:
 Power Pole SE 63.16
 Power Pole WSW 38.82
 Telephone Pole NW 67.97

(See Back of Page)

B. Description of corner evidence found and/or method applied in restoring or reestablishing corner:
 C-8 1/4 corner common to Sections 19 & 20

Found 4" Harrison CIM 6" Deep, 10'+/- E. of Road E
 Found P.P. SE 63.16'
 Found P.P. WSW 38.82'
 Found T.P. NW 67.97'

P.A. 345 OTTAWA COUNTY
 PEER APPROVED 12/12/94
Robert D. Newell


Accepted as a careful and faithful perpetuation of the original position of the corner.

C. Description of monument for corner and accessories established to perpetuate locating the position of the corner:
 C-8 1/4 corner common to Sections 19 & 20

4" Harrison Cast Iron Monument
 O.C. Remon. Tag & Nail in N.E. side P.P. S41°E 63.14'
 O.C. Remon. Tag & Nail in S. side P.P. S77°W 39.31'
 O.C. Remon. Tag & Nail in S.W. side Tel. P. N39°W 67.87'
 O.C. Remon. Tag & Nail in N.W. side 20" Maple N62°E 49.91'

Signed by Carl P. Englert Jr.
 Surveyor's Michigan License No. 18987

Date 12/7/94

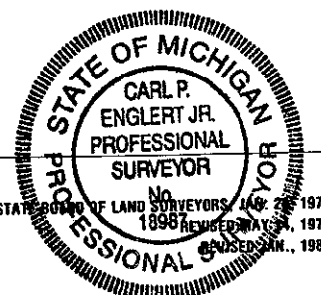

FORM APPROVED BY MICHIGAN STATE BOARD OF LAND SURVEYORS, 1987
 18987
 1983

LCRC Liber 1, Page 437 (6/1/72)

C-8 Found Steel Bar

Nail in Face of Tel. Pole	NW	68.10'
Nail in Face of P.P.	SE	63.20'
Nail in Face of P.P.	WSW	38.75'